

Saline

KANSAS

Sec. 25 Twp. 15 R. 4 W

Well No. # 4 Swenson Farm

Musgrove Petroleum Company

Musgrove Contractor

Smolan Pool


Ft. from N. Line

990 Ft. from S. Line

Ft. from E. Line

990 Ft. from W. Line

NE SW NE

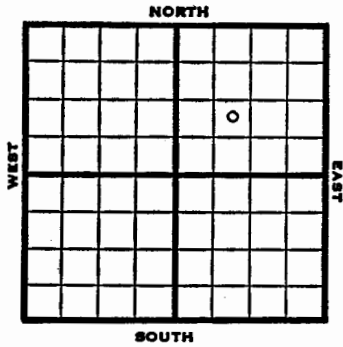


KANSAS

Section 25 Township 15 Range 4W

Well No. #4 Swenson

Company Musgrove Petroleum

NORTH

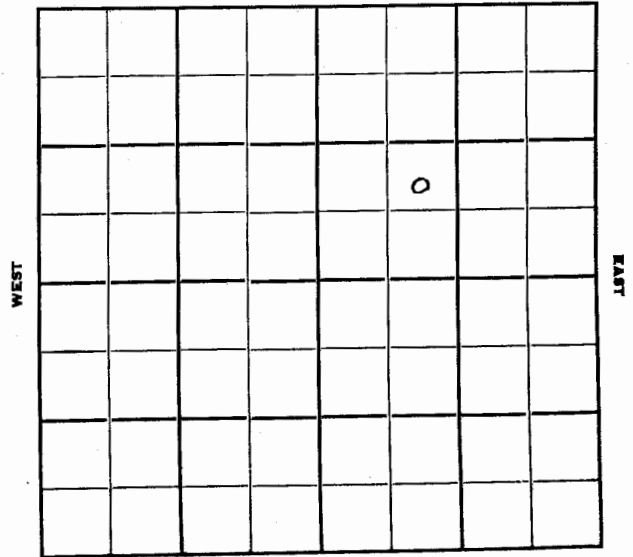

SOUTH

1951 Elev. 1291' REPORT

8/15 R U R
 10/10 Spud 8-14-51
 Oil well TD 3410
 8" @ 350' Maq. dol. 3407-10
 5 1/2" @ 3408' TD 3410
 S/ 1 1/4" BOPH 300A S/ 6 BOPH
 Comp. 387 BOPD

COMPLETED