

County Saline State Kansas
 Sec. 25 (Blk. 15) (Sur. 4W) Map No. 4W
 Operator Musgrove
 Well No. 3 Farm Swenson
 Elev. 1296 Location NE SE NE

990 Ft. From S Line NE
330 Ft. From E Line Quarter
 1st. Report JUL 3 1951
 Completion
 Remarks Victor Drlg. - Contr.
 Spudding Date 7-2-51

Drlg. Data

Drilling 250

J. E. TYRA

County Saline State Kansas
 Sec. 25 (Blk. 15) (Sur. 4W) Map No. 4W
 Operator Musgrove Pet.
 Well No. 3 Farm Swenson
 Elev. 1296 Location NE SE NE

990 Ft. From S Line NE
330 Ft. From E Line Quarter
 1st. Report
 Completion AUG 22 1951
 Remarks Victor Drlg. - Contr.
 Spudding Date 7-2-51

Drlg. Data Oil well TD 34048" @ 355 Miss. 2840 Kh. 3162Hunton 3298 Viola 3402-03 4 1/2" @ 3402CO to 3403 1 1/2 boph DD 3404 S/ 2 1/2 boph500 A S/ 6 boph Comp. 489 bopd 1% water

J. E. TYRA

Saline **KANSAS**
15 **4W**

Sec. 25 Twp. 15 R. 4W

Well No. #3 Swensen Farm

Musgrove Company

Victor Drlg. - Contr. Contractor


 Ft. from N. Line

990' Ft. from S. Line

330' Ft. from E. Line

 Ft. from W. Line

NE SE NE

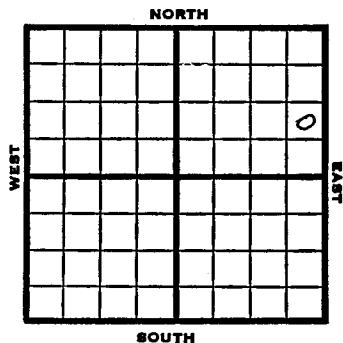

1951 Elev. 1296' REPORT

7/3 Drlg. 250'
8/22 Spud 7-2-51
Oil well TD 3404' 8" @ 355'
Miss 2840' Kh. 3162' Hunton 3298'
Viola 3402-03' 4 1/2" @ 3402'
CO to 3403' 1 1/2 BOPH DD 3404'
S/2 1/2 BOPH 500 A S/6 BOPH
Comp. 489 BOPD 1% water.
COMPLETED

KANSAS

Section 25 Township 15 Range 4 W

Well No. # 3 Swensen

Company Musgrove

