

Saline

KANSAS

Sec. 25 Twp. 15 R. 4 W ✓

Well No. # 2 Swenson Farm

Musgrove Pet. Company

Victor Contractor

Smolan Pool


330 Ft. from N. Line

_____ Ft. from S. Line

_____ Ft. from E. Line

990 Ft. from W. Line

NE NW NE

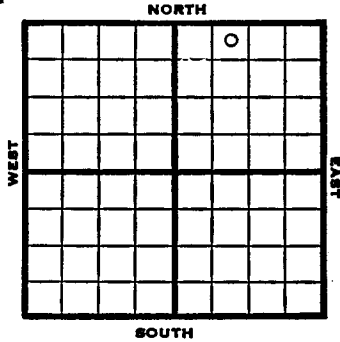


Saline KANSAS

Section 25 Township 15 Range 4W

Well No. #2 Swenson

Company Musgrove Pet.

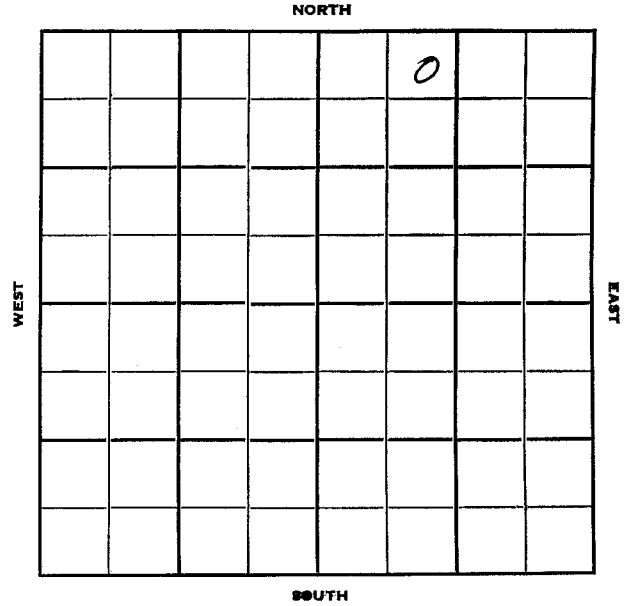

1951

lev. 1292' REPORT

6/13

R U R Set Surf.

7/25

Oil well TD 3415' 8" @ 168'
lost circ @ 410' Skid rig 50' south
8" @ 342 Maq. 3410-13'
5" @ 3410' TD 3415' S/1 BOPH
1000 A S/10 BFPH 25% water
Comp. 265 BOPD 48% water

COMPLETED