

County **Saline** State **Kansas**
 Sec. **25** (Blk. Twp.) **15** (Sur. Rge.) **4W** Map No.
 Operator **Musgrove et al.**
 Well No. **1** Farm **Swensen**
 Elev. **1290** Location **NE NE NE**

 330 Ft. From **N** Line **NE**
 330 Ft. From **E** Line **Quarter**
 1st. Report **DEC 2 1950**
 Completion
 Remarks
Melland - Contr.
 Spudding Date **12-10-50**
 Drlg. Data **Smolan Pool**
drlg. 100

J. E. TYRA

County **Saline** State **Kansas**
 Sec. **25** (Blk. Twp.) **15** (Sur. Rge.) **4W** Map No.
 Operator **Musgrove Pet. et al.**
 Well No. **1** Farm **Swensen**
 Elev. **1290-** Location **NE NE NE**

 330 Ft. From **N** Line **NE**
 330 Ft. From **E** Line **Quarter**
 1st. Report
 Completion **JAN 21 1951**
 Remarks **Smolan Pool**
Melland - Contr.
 Spudding Date **12-10-50**
 Drlg. Data **Oil well TD 3410 $\frac{1}{2}$**
8" @ 319 Miss. 2851 Viola 3404
5" @ 3404 TD 3407 FU 400' oil DD 3410
S/ 5 $\frac{1}{2}$ boph DD 3410 $\frac{1}{2}$ FU 2430' oil 17 hr.
S/ 7 boph Comp. 351 bopd

J. E. TYRA

KANSAS

Saline

Sec. 25 Twp. 15 R. 4-W

Well No. #1 Swensen Farm

Musgrove et al Company


Melland Contractor

Smolan
330 Ft. from N. Line

 Ft. from S. Line

330 Ft. from E. Line

 Ft. from W. Line
NE NE NE

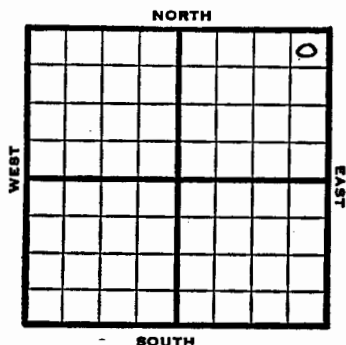

1950 Elev 1290' REPORT

12/13 Spud 12-10-50
Drlg 100'

1951
1/31 Spud 12/10-50
Oil well TD 3410½
8" @319
Miss 2851 Viola 3404
5" @3404 TD 3407
FU 400' oil DD 3410
S/ 5½ boph DD 3410½ FU 2430' oil
17 hr. S/ 7 boph
Comp. 351 bopd

COMPLETED

Saline

KANSAS

Section 25 Township 15 Range 4W

Well No. #1 Swensen

Company Musgrove et al

