



Saline

KANSAS

Sec. 25 Twp. 15 R. LW

Well No. #2 Gilbert Johnson Farm

E. K. Carey Drlg. Company

Carey Contractor


Ft. from N. Line

330 Ft. from S. Line

330 Ft. from E. Line

Ft. from W. Line

SE SE NW

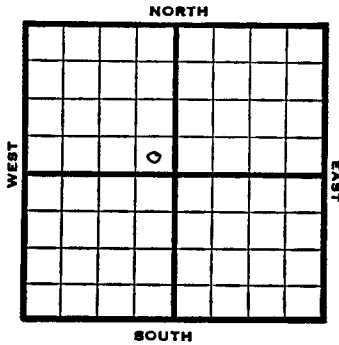


Saline

Section 25 Township 15 Range 4 W

Well No. # 2 Gilbert Johnson

Company E. K. Carey Drlg.

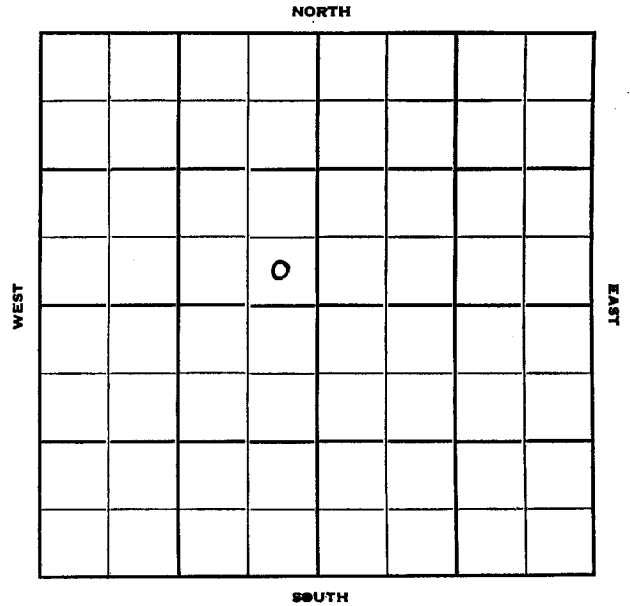

1952 Elev. 1289' REPORT

- 2/13 Spud 2-8-52  
15" @ 83 8" @ 327'  
Drlg. 765'
- 2/20 KC 2225' Miss 2278'  
Drlg. 3146'
- 3/5 WOCT
- 3/11 MICT
- 3/19 DP CO 3409  
S/4 1/2 BOPH POP
- 4/2 Spud 2-8-52  
Oil Well TD 3409  
15" @ 83 8" @ 327'  
KC 2225 Miss 2868  
Kh 3178 Hunton 3316  
TD 3409 5" @ 3408  
CO to 3409 S/4 1/2 boph 500 A  
Comp. 213 bopd

**COMPLETED**