

County Saline State Kansas
 Sec. 25 (Blk. 15) (Sur. 4W) Map No.

Operator E. K. Carey

Well No. 1 Farm Johnson

Elev. Location NE SE NW

FIRST REPORT									

990 Ft. From S Line NW

330 Ft. From E Line Quarter

1st. Report JUN 27 1951

Completion

Remarks

E. K. Carey - Contr.

Spudding Date

Drig. Data Smolan Pool

RUR

J. E. TYRA

County Saline State Kansas
 Sec. 25 (Blk. 15) (Sur. 4W) Map No.

Operator E. K. Carey

Well No. 1 Farm Johnson

Elev. 1296 Location NE SE NW

COMPLETE									

990 Ft. From S Line NW

330 Ft. From E Line Quarter

1st. Report

AUG 15 1951

Completion

Remarks Smolan Pool

Carey - Contr.

Spudding Date 6-26-51

Drig. Data Oil well TD 3415

8" @ 341 Miss. 2883 KH. 3184

Misencor 3322 Hunton 3327 Maq. sh. 3339

Maq. dol. 3413 TD 3415 4 1/2" @ 3414

CO to 3415 S/ 35 boph

Comp. 116 bopd 1% water

J. E. TYRA

Saline KANSAS

Sec. 25 Twp. 15 R. 4W

Well No. #1 Johnson Farm

E. K. Carey Company

E. K. Carey - Contr. Contractor

Smoland Pool


Ft. from N. Line

990' Ft. from S. Line

330' Ft. from E. Line

Ft. from W. Line

NE SE NW

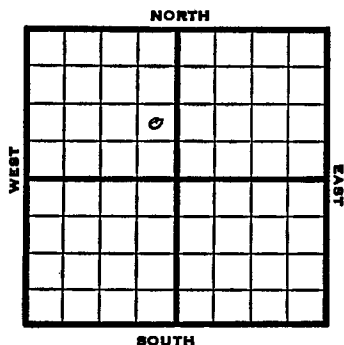


KANSAS

Section 25 Township 15 Range 4 W

Well No. # 1 Johnson

Company E. K. Carey

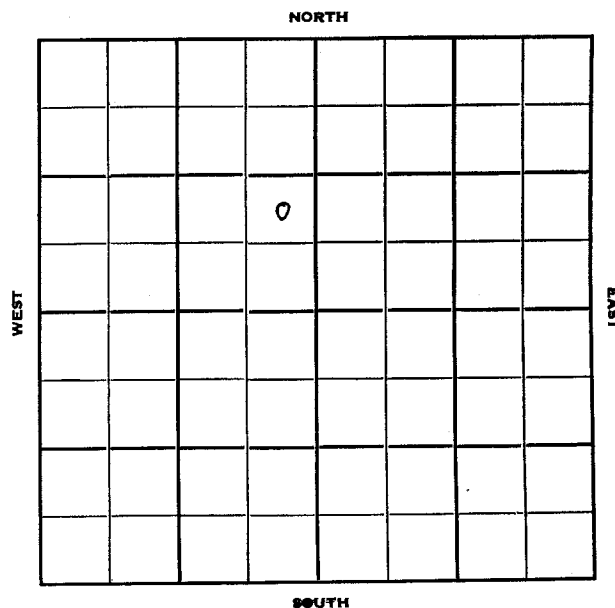

1951 Elev. 1296' REPORT

6/27 RUR

8/15 Spud 6-26-51
Oil well TD 3415' 8" @ 341
Miss. 2883' KH. 3184' Misenor 3322'
Hunton 3327' Maq. sh. 3339'
Maq. dol. 3413' TD 3415'
4 1/2" @ 3414' CO to 3415'
S/35 BOPH
Comp. 116 BOPD 1% water

COMPLETED