

Saline KANSAS ✓

Sec. 25 Twp. 15 R. 4W

Well No. #6 Gustafson Farm

Republic Natural Company

Contractor

Smolan Pool


990 Ft. from N. Line

Ft. from S. Line

Ft. from E. Line

990 Ft. from W. Line

SE NW SE

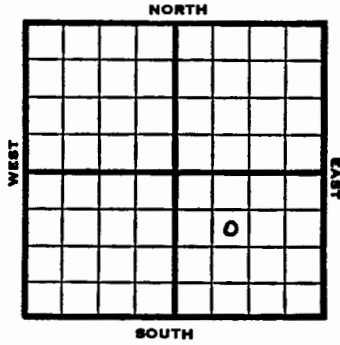

1953 Elev. 1294' REPORT

4/15 Location

4/23 "

4/30 10" @ 359
Drlg. 1840'

5/7 Drlg. 3285

5/21 NR

5/28 "

6/3 "

6/24 Spud 4-17-53 Oil well TD 3451
10" @ 359 Viola 3405 TD 3451
5" @ 3451 24/3406-10 1000 A
S/36 BO 6 hr.
Comp. 95 BOPD

COMPLETED


Saline KANSAS

Section 25 Township 15 Range 4W

Well No. # 6 Gustafson

Company Republic Natural

NORTH

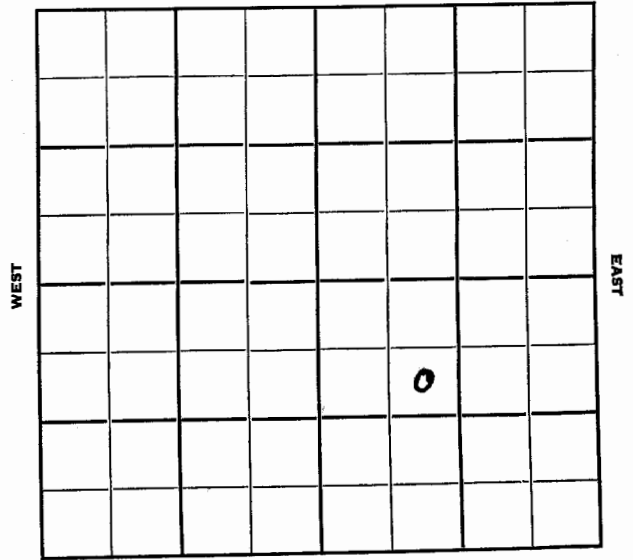

SOUTH