

County **Saline** State **Kansas**
 Sec. **25** (Bk. **15** (Sur. **4W** Map No.
 Operator **E. K. Carey et al.**
 Well No. **4** Farm **Gustafson**
 Elev. Location **NW NW SE**

330 Ft. From **N** Line **SE**
330 Ft. From **W** Line Quarter
 Ist. Report **SEP 24 1952**
 Completion
 Remarks
Carey Drlg. - Contr.
 Spudding Date **9-20-52**

Drlg. Data
8" @ 335 drlg. 1450

J. G. McGEHEE

County **Saline** State **Kansas**
 Sec. **25** (Bk. **15** (Sur. **4W** Map No.
 Operator **E. K. Carey et al.**
 Well No. **4** Farm **Gustafson**
 Elev. **1293** Location **NW NW SE**

330 Ft. From **N** Line **SE**
330 Ft. From **W** Line Quarter
 Ist. Report
 Completion **DEC 17 1952**
 Remarks
Carey Drlg. - Contr.
 Spudding Date **9-20-52**

Drlg. Data **Cil well TD 3416**

8" @ 335 Lans. 2236 Miss. 2382
Kh. 3181 Misener 3314 Hunton 3316
Maq. sh. 3336 Maq. dol. 3404 TD 3406
5" @ 3405 DD 3416 S/ 3 boph 1000 A
S/ 6 boph Comp. 163 bopd 2% wtr.

J. G. McGEHEE

Saline KANSAS

Sec. 25 Twp. 15 R. 4 W

Well No. # 4 Gustafson Farm

E. K. Carey et al Company

Carey Drlg. Contractor


330 Ft. from N. Line

Ft. from S. Line

Ft. from E. Line

330 Ft. from W. Line

NW NW SE

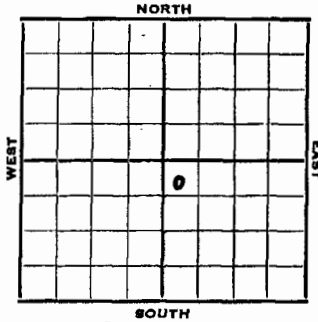

(Information Brought Forward)

1952
12/17

3404
TD 3406
5" @ 3405
DD 3416
S/3 boph 1000A
S/6 boph
Comp. 163 bopd 2% wtr.

COMPLETED

1952	Elev. 1293' REPORT
9/24	Spud 9-20-52 8" @ 335 Drlg. 1450'
10/2	Drlg. 3288'
10/8	Lans 2236, Miss 2282, Kh 3181, Misner 3314', Hunton 3316', Mq. Sh 3363, Dol 3404 RTD 3406 5" @ 3405'
10/15	Drlg. Deeper 3416 TD S/3 BOPH 1000A
10/22	S/6 BOPH
10/29	NR
11/5	"
11/12	"
11/20	"
11/27	"
12/4	"
12/11	NR
12/17	Spud 9-20-52 Oil Well TD 3416' 8" @ 335 Lans 2236, Miss 2882', Kh. 3181', Misner 3314, Hunton 3316' Maq. sh. 3336, Maq. dol.

OVER

Section 25 Township 15 Range LW

Well No. #4 Gustafson

Company E. K. Carey et al

