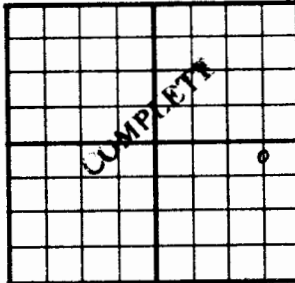


County	Saline		State	Kansas	
Sec.	25	(Blk. Twp.) 15	(Sur. Rge.) 4W	Map No.	
Operator	E. K. Carey				
Well No.	3	Farm	Gustafson		
Elev.	Location C N L NE SE				
					
330 Ft. From N Line SE					
660 Ft. From E Line Quarter					
1st. Report JUL 30 1950					
Completion					
Remarks					
Carey Drlg. - Contr.					
Spudding Date					

Drlg. Data

M I M

J. G. McGEHEE

County	Saline		State	Kansas	
Sec.	25	(Blk. Twp.) 15	(Sur. Rge.) 4W	Map No.	
Operator	E. K. Carey				
Well No.	3	Farm	Gustafson		
Elev.	1291	Location C N L NE SE			
					
330 Ft. From N Line SE					
660 Ft. From E Line Quarter					
1st. Report					
Completion OCT 8 1952					
Remarks					
Carey Drlg. - Contr.					
Spudding Date 7-30-52					

Drlg. Data

Oil well TD 3657

8" @ 305 Miss. 2872 Kh. 3170

Shy. Misener 3296 Misener sd. 3311

Hunton 3314 Maq. 3402 Simp. 3557

Arb. 3633 TD 3657 4" @ 3655

28/ 3400-07 500 A S/ 12 boph

Comp. 240 bopd 4% water

J. G. McGEHEE

Sec. 25 Twp. 15 R. 14WWell No. #3 Gustafson Farm

E. K. Carey Company

Carey Drlg. Contractor


330 Ft. from N. Line

Ft. from S. Line

660 Ft. from E. Line

Ft. from W. Line

C N L N E S E

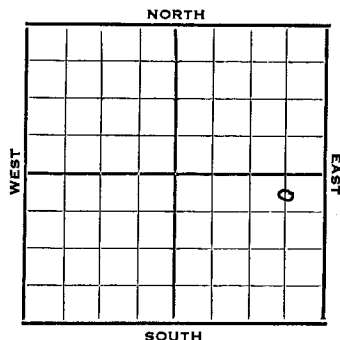

1952 Elev. 1291' REPORT

7/30 MIM
8/6 8" @ 305'
Drlg. 2040'
8/13 Maq. Dol 3402
f 3394-3424'
8/20 TD 3471' 4" @ 3455'
8/27 Miss 2872 KH 3170 Shaley Meisner
Meisner sd 3311 3296
Htn 3314 Simp 3557
Arb. 3633 RTD 3357
4" @ 3455 Ran Log
9/3 28/3400-3407 500 A S/ 12 Boph
9/10 NR
9/17 "
9/24 "
10/1 "
10/8 Spud 7-30-52
Oil Well TD 3657 8" @ 305
Miss. 2872 Kh. 3170
Shy Misener 3296 Misener sd 3311
Hunton 3314 Maq. 3402
Simp. 3557 Arb. 3633
TD 3657 4" @ 3455
28/ 3400-07 500 A S/ 12 boph
Comp. 240 bopd 4% wtr.

COMPLETED

Section 25 Township 15 Range 14WWell No. #3 GustafsonCompany E. K. Carey