


County Saline State Kansas
 Sec. 25 (Blk. 15) (Sur. 4W) Map No.
 Operator E. K. Carey et al.
 Well No. 1 Farm Gustafson
 Elev. _____ Location SE SE SE

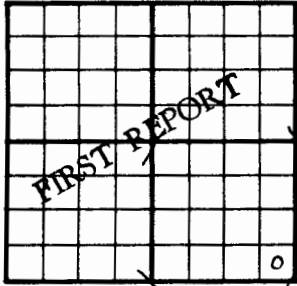

330 Ft. From S Line SE
330 Ft. From E Line Quarter

Ist. Report SEP 12 1951

Completion _____

Remarks _____

Spudding Date _____


Drig. Data _____

Smolan Pool

Cellar & pits

J. E. TYRA

County Saline State Kan
 Sec. 25 (Blk. 15) (Sur. 4W) Map No.
 Operator E. K. Carey et al.
 Well No. 1 Farm Gustafson
 Elev. 1298 Location SE SE SE

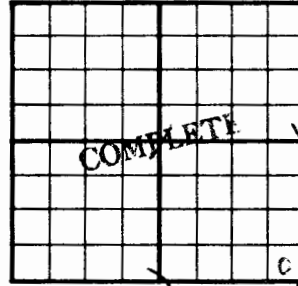

330 Ft. From S Line SE

330 Ft. From E Line Quarter

Ist. Report _____

Completion DEC 5 1951

Remarks Smolan Pool

Spudding Date 10-6-51

Drig. Data Oil well TD 3408

8" @ 310 KC 2240 Miss. 2896

Hunton 3316 Maq. 3404 TD 3408

5" @ 3404 CO to 3408 S/ 9 boph

Comp. 507 bopd

J. E. TYRA

Saline

KANSAS

Sec. 25 Twp. 15 R. 4 W

Well No. #1 Gustafson Farm

E. K. Carey et al Company

Contractor

Smolan Pool


Ft. from N. Line

330 Ft. from S. Line

330 Ft. from E. Line

Ft. from W. Line

SE SE SE

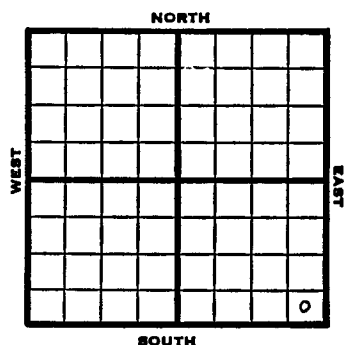

1951 Elev. 1298' REPORT

9/12 Cellar & Pits

12/5 Spud 10-6-51

Oil Well TD 3408

8" @ 310

KC 2240 Miss 2896

Hunton 3316 Maq. 3404

TD 3408

CO to 3408 S/ 9 BOPH

Comp. 507 BOPD

COMPLETED

Saline


KANSAS

Section 25 Township 15 Range 4W

Well No. #1 Gustafson

Company E. K. Carey et al

NORTH

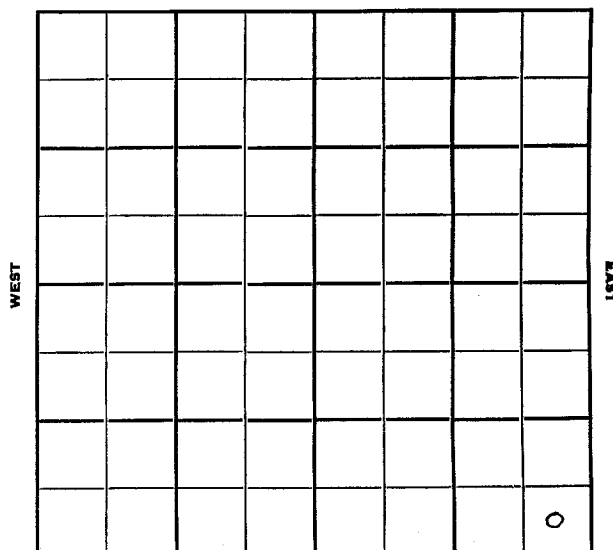

SOUTH