



Sec. 25 Twp. 15 R. _____

Well No. #4 Frost Farm _____

Republic Natural Gas Company _____

E. K. CAREY Contractor
Smolan Pool


990 Ft. from N. Line

_____ Ft. from S. Line

990 Ft. from E. Line

_____ Ft. from W. Line


SW NE SW

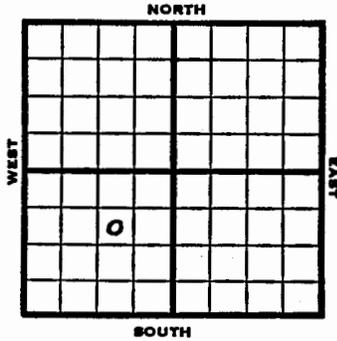

Section 25 Township 15 Range 4W

Well No. #4 Frost

Company Republic Natural Gas

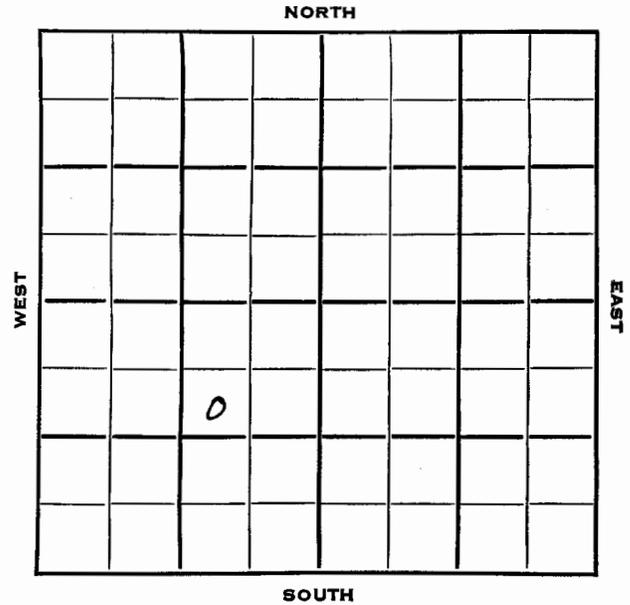

1953 Elev. 1297' REPORT

- 4/22 Location
 - 4/30 "
 - 5/7 10" @ 330
Drlg. 376
 - 5/21 V 3415'
DST 3413-18', 1 hr, 35' SOCM 215#
RTD 3466 7" @ 3466
 - 5/28 Pipe parted 3100'
 - 6/3 N.R.
 - 6/10 To Whipstock
 - 6/24 No report
 - 7/1 1 BO + 1 BWP 8 hrs.
 - 7/8 N.R.
 - 7/22 NR
 - 7/29 Spud 4-28-53 Oil well TD 3466
10" @ 330 Viola 3415
DST 3413-18 open 1 hr rec 35' SOCM
215# TD 3466 7" @ 3466 Kh. 3180
Hunton 3320 Maq. 3343 Maq. dol 3415
5" @ 3454 TD 3466 10/3415-17
5 GPH 1000 A S/30 GO 30 GWPH
S/1 BO 1 BWP 8 hr.
Comp. 30 BOPD 40% wtr.
- COMPLETED**