

Sec. 25 Twp. 15 R. 4 W

Well No. # 3 Frost Farm

Republic Natural Gas Company

Carey Drlg. Contractor

Smolan Pool


Ft. from N. Line

660 Ft. from S. Line

660 Ft. from E. Line

Ft. from W. Line

C SE SW

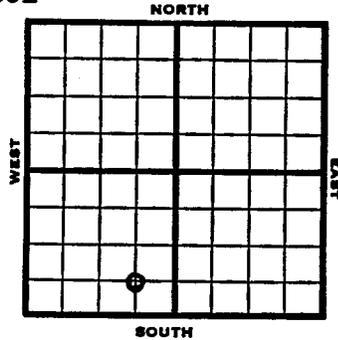


Section 25 Township 15 Range 4 W

Well No. #3 Frost

Company Republic Natural Gas Company

NORTH

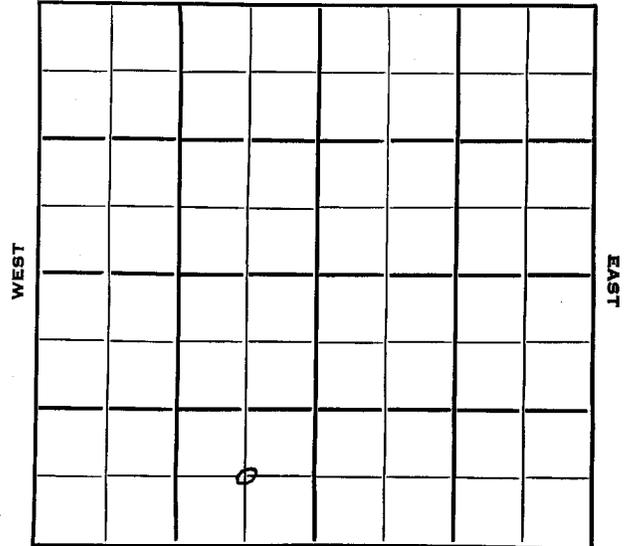

SOUTH

1953 Elev. 1298' REPORT

- 3/11 Location
- 3/19 "
- 3/26 10" @ 365
Drlg. 2415'
- 4/2 V 3412' RTD 3457 5" @ 3457
- 4/9 KH 3147, Meisner 3315, Htn 3318, Mg
sho 3335 V 3405
Schl tops 30/3406-11 1000A
S/ 33 BO 8 Hrs.
POP
- 4/16 NR
- 4/23 NR
- 4/29 Spud 3-16-53
Oil well
TD 3457
10" @ 365
Kh 3147, Misener 3315, Hunton 3318,
Maq. sh. 3335, Viola 3405
TD 3457,
30/3406-11, 1000A
S/33 bo 8 hrs.
Comp. 130 bopd

COMPLETED