


County **Saline** State **Kansas**

Sec. **25** (Blk. Twp.) **15** (Sur. Rge.) **4W** Map No.

Operator **E. K. Carey**

Well No. **2** Farm **Willie Frost**

Elev. Location **NE NE SW**

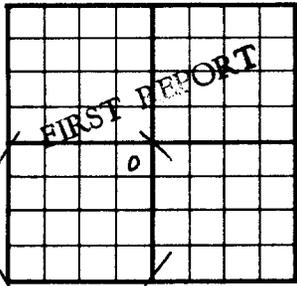

330 Ft. From **N** Line **SW**

330 Ft. From **E** Line Quarter

Ist. Report **MAR 19 1952**

Completion

Remarks

Carey Drlg. - Contr.

Spudding Date **3-18-52**

Drlg. Data **Smolan Pool**

8" @ 375 WOC

J. G. McGEHEE


County **Saline** State **Kansas**

Sec. **25** (Blk. Twp.) **15** (Sur. Rge.) **4W** Map No.

Operator **E. K. Carey**

Well No. **2** Farm **Willie Frost**

Elev. **1294** Location **NE NE SW**

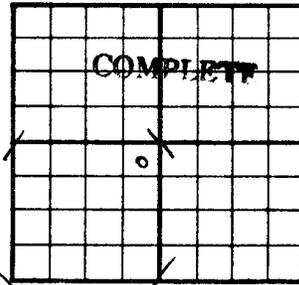

330 Ft. From **N** Line **SW**

330 Ft. From **E** Line Quarter

Ist. Report

Completion **APR 22 1952**

Remarks **Smolan Pool**

Carey Drlg. - Contr.

Spudding Date **3-18-52**

Drlg. Data **Oil well TD 3413**

8" @ 375 **Maq. 3404-3410** **5" @ 3408**

TD 3413 S/ 1 both 6 hr.

Miss. 2870 Kh. 3180 Hunton 3320

500 A Comp. 217 bopd

J. G. McGEHEE

Saline

KANSAS

Sec. 25 Twp. 15 R. 4W

Well No. #2 Willie Frost Farm

E. K. Carey Company

Carey Drlg. Contractor

Smolan Pool


330 Ft. from N. Line

Ft. from S. Line

330 Ft. from E. Line

Ft. from W. Line

NE NE SW

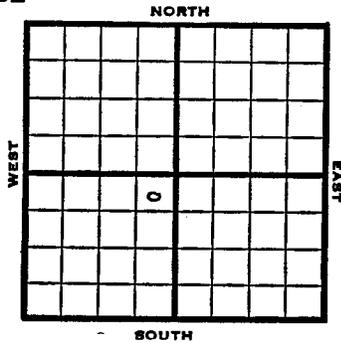

Saline


KANSAS

Section 25 Township 15 Range 4 W

Well No. # 2 Willie Frost

Company E. K. Carey

NORTH

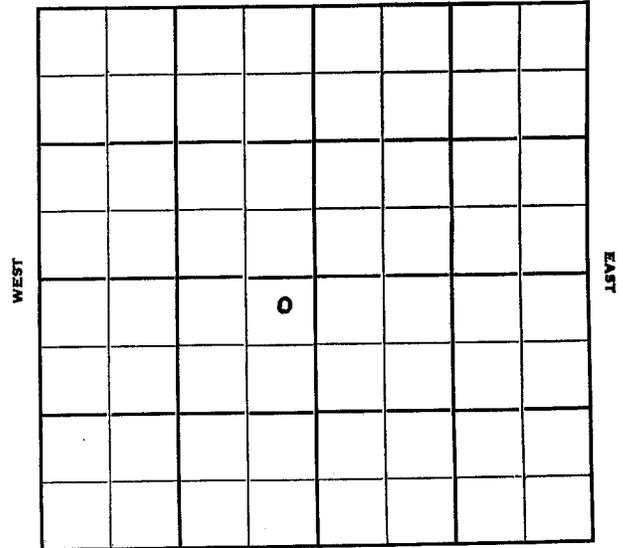

SOUTH

1952 Elev. 1294' REPORT

3/19 Spud 3-18-52
8" @ 375' WOC

3/25 Drlg. 2670'

4/1 Mq. Dol. 3404-3410 RTD
5" @ 3408' WOC

4/9 CO DD to 3413 S/1 Boph 6 hrs.
tub & rods Miss 2370
KH 3180 Htn 3320
RTD 3410 5" @ 3408

4/23 Spud 3-18-52
Oil Well TD 3413' 8" @ 375
Maq. 3404-3410 5" @ 3408
TD 3413 S/ 1 boph 6 hr.
Miss. 2870 KH 3180 Hun 3320
500 A Comp 217 bopd

COMPLETED