

County Saline State Kansas

Sec. 25 (Blk. 15 (Sur. 4W Map No.)
(Twp.) (Rge.)

Operator E. K. Carey et al.

Well No. 1 Farm Front

Elev. Location SW SW SW

330 Ft. From S Line SW
330 Ft. From W Line Quarter

lst. Report AUG 15 1951

Completion

Remarks

Carey Drlg. - Contr.

Spudding Date 8-11-61

Drig. Data Smolian Pool

8" @ 335 drlg. 1140

J. E. TYRA

County Saline State Kansas

Sec. 25 (Bk.) 15 (Sur.) 4W Map No.
(Twp.) (Rge.)

Operator E. K. Carey etal.

Well No. 1 Farm Frost

Elev. 1300 Location SW SW SW

330 Ft. From S Line SW

330 Ft. From W Line Quarter

1st. Report

Completion OCT 3 1951

Remarks Smolan Pool

Carey Drlg. - Contr.

Spudding Date 8-11-51

Drlg. Data Oil well TD 3415

J. E. TYRA

Saline

KANSAS

Sec. 25 Twp. 15 R. 4 W

Well No. #1 Frost Farm

E. K. Carey et al Company

Carey Drlg. Contractor

Smolan Pool


Ft. from N. Line

330 Ft. from S. Line

Ft. from E. Line

330 Ft. from W. Line

SW SW SW

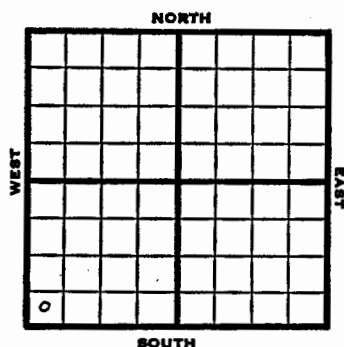

1951 Elev. 1300' REPORT

8/15 Spud 8-11-51
8" @ 335
Drlg. 1140'

10/3 Spud 8-11-51 Oil well TD 3415'
8" @ 335' Burgess sand 2901'
Miss 2905' Kh. 3182' Misenor 3322'
Hunton 3324' Maq. 3343' Maq. dol.
3413-15' TD
4 1/2" @ 3414 CO to 3415' FU 2555'
oil 12 hr. S/15 1/2 BOPH 1000 A
Comp. 1865 BOPD

COMPLETED

Section 25 Township 15 Range 4 W

Well No. #1 Frost

Company E. K. Carey et al

