

County **Saline** State **Kansas**

Sec. **25** (Blk.) **15** (Sur.) **4W** Map No.

Operator **W. G. Bruns**

Well No. **1** Farm **Dahlsten "B"**

Elev. _____ Location **C W L NE NW**

04					

FIRST REPORT

000 Ft. From **N** Line **NW**

000 Ft. From **E** Line **Quarter**

1st. Report **MAY 29 1951**

Completion _____

Remarks **Sterling Drig. - Contr.**

Spudding Date **5-26-51**

Drig. Data **Smolan Pool**

8" @ 330 drig, 370

See correction

J. E. TYRA

Form 26 200 Bks. 8-50 Petrol

Kansas

Map No. _____ Sec. **25** Twp. **15** R. **4W**

Well No. **1 Dahlsten "B"**

W. G. Bruns Company

CORRECTION

Contractor

C N L NW/4

SECTION PLAT

0			

330 Ft. from N. Line

Ft. from S. Line

1320 Ft. from E. Line

Ft. from W. Line

Saline County

Location _____

Rig up _____

Drilling and Remarks:

Reported

C W L NE NW

RECORD

Cased _____ in., _____ ft.

Sand _____

Gas _____

Oil _____

Total Depth _____

PRODUCTION

1st 24 hrs. Nat. _____

1st 24 hrs. after shot _____

Gas _____ Cu. Ft.

Dry Hole _____

Abandoned _____

Date

MAY 29 1951 19

J. E. TYRA

Scout

Saline

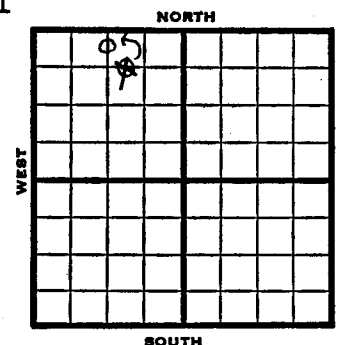
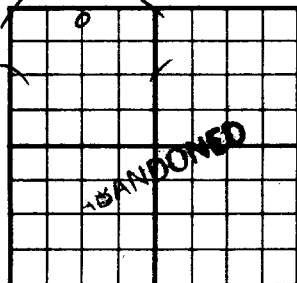
KANSAS

Sec. 25 Twp. 15 R. 4 WWell No. # 1 Dahlsten "B" FarmW. G. Bruns CompanySterling Drlg. ContractorSmolan Pool330
660 Ft. from N. Line

Ft. from S. Line

1320
990 Ft. from E. Line

Ft. from W. Line

C N L NW/4
C W L NE NWCounty Saline State KansasSec. 25 (Bk. Twp.) 15 (Sur. Rge.) 4W Map No.Operator W. G. BrunsWell No. 1 Farm Dahlsten "B"Elev. 1304 Location C N L NW330 Ft. From N Line NW1320 Ft. From E Line Quarter

1st. Report

Completion JUN 13 1951Remarks Smolan PoolSterling Drlg. - ContrSpudding Date 5-26-51Drlg. Data D & A TD 34328" @ 330 Miss. 2904 Kinderhook3193 Misenor 3326 Hunton 3332Maq. 3358 Dol. 3428 DST 3429-32open 3/4 hr. Rec. 330' sw TD 3432D & A

J. E. TYRA

1951 Elev. 1304' REPORT5/29 Spud 5-26-518" @ 330Drlg. 370'6/13 Spud 5-26-51D & A TD 3432' 8" @ 330Miss 2904' Kinderhook 3193'Misenor 3326' Hunton 3332'Maq. 3358' Dol. 3428'DST 3429-32 open 3/4 hr. rec 330' SWTD 3432' D & A**ABANDONED**

Saline KANSAS

Section 25 Township 15 Range 4WWell No. #1 Dahlsten "B"Company W. G. Bruna