


Kansas

County Saline State Kansas
 Sec. 25 (Blk.) 15 (Sur.) 4W Map No.
 Operator W. G. Brunn
 Well No. 3 Farm Dahlstein
 Elev. _____ Location C W L NW NW

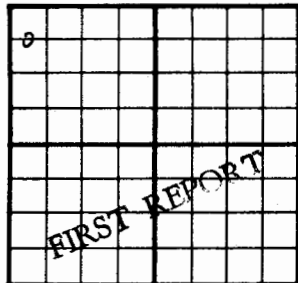

660 Ft. From N Line NW
330 Ft. From W Line Quarter
 1st. Report DEC 5 1951
 Completion _____
 Remarks Honaker Drlg. - Contr.
 Spudding Date _____

Drig. Data Smolan Pool

R U R


Map No. _____ Sec. 25 Twp. 15 R. 4W
 Well No. 3 Dahlstein

W. G. Bruns Company

CONSTRUCTION Contractor

SW NW NW

SECTION PLAT

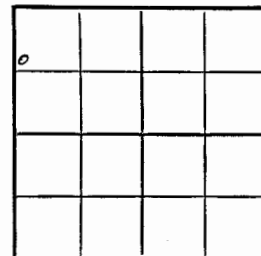

990 Ft. from N. Line

_____ Ft. from S. Line

_____ Ft. from E. Line

330 Ft. from W. Line

Saline County

Location _____

Rig up _____

Drilling and Remarks:

Reported

C W L NW NW

RECORD

Cased _____ in., _____ ft.

Sand _____

Gas _____

Oil _____

Total Depth _____

PRODUCTION

1st 24 hrs. Nat. _____

1st 24 hrs. after shot _____

Gas _____ Cu. Ft.

Dry Hole _____

Abandoned _____

Date

DEC 12 1951

19


J. E. TYRA

Scout

J. E. TYRA

Saline KANSAS

County Saline State Kansas
 Sec. 25 (Bk. 15) (Sur. 4W) Map No.
 Operator W. G. Bruns
 Well No. 3 Farm Dahlstein
 Elev. 1308 Location SW NW NW

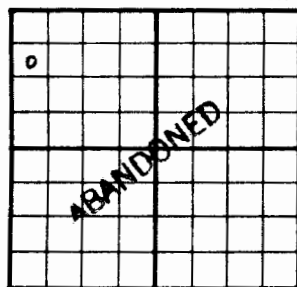

990 Ft. From N Line NW
330 Ft. From W Line Quarter

1st. Report

Completion JAN 9 1951

Remarks Smolan Pool
Honaker Drlg. - Contr.

Spudding Date 12-5-51Drlg. Data D & A TD 34378" @ 320 Miss. 2901 Kh. 3196Hunton 3344 Maq. 3366 Dol. 3435DST 3435-37 open 20 min. Rec. 25' mud& water & SSO 5" @ 3435 TD 3437 HFWD & A


J. E. TYRA

Sec. 25 Twp. 15 R. 4WWell No. # 3 Dahlstein FarmW. G. Brunn CompanyHonaker Drlg. Contractor990 660 Smolan Pool

Ft. from N. Line

Ft. from S. Line

Ft. from E. Line

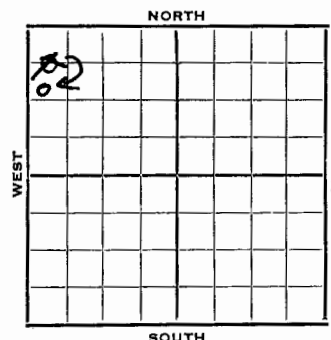330 Ft. from W. LineSW NW NW
SW L NW NWElev. 1308' REPORT

1951

12/5

RUR

1952

1/9

Spud 12-5-51D & A TD 3437' 8" @ 320'Miss 2901' Kh. 3196' Hunton 3344'Maq. 3366' Dol. 3435'DST 3435-37 open 20 min. rec 25' mud& water & SSO 5" @ 3435 TD 3437'HFW D & A

ABANDONED

Section 25 Township 15 Range 4W

Well No. #3 Dahlstein

Company W. G. Brunn

