

Saline

KANSAS

Sec. 25 Twp. 15 R. 4 W

Well No. # 2 Dahlstien Farm _____

W. G. Bruns Company _____

Honaker Drlg. Contractor _____

Smolan Pool


990 Ft. from N. Line

_____ Ft. from S. Line

330 Ft. from E. Line

_____ Ft. from W. Line

SE NE NW

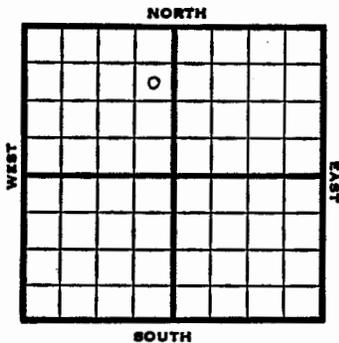


KANSAS

Section 25 Township 15 Range 4W

Well No. #2 Dahlstien

Company W. G. Bruns

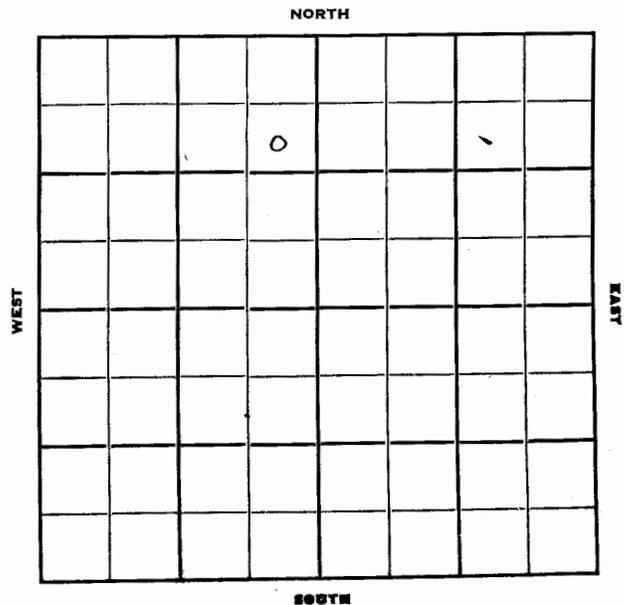

1951

Elev. 1298' REPORT

8/15

Spud 8-12-51
Rng 12" @ 60'

11/14

Spud 8-12-51
Oil well TD 3422' 12" @ 60
8" @ 323 Miss 2892' Kh. 3190'
Misener 3324' Hunton 3328'
Maq. sh. 3345' Maq. dol. 3419'
DST 3420-22 open 45 min. rec 163' oil
2' SW
5" @ 3419' TD 3422' 9/3420-22
250 A S/15 BOPH
Comp. 75 BOPD

COMPLETED