

County Saline State Kansas

Sec. 26 (Blk. Twp.) 15 (Sur. Rge.) 4W Map No.

Operator M & H Pet.

Well No. 1 Farm Nelson

Elev. Location SE SE NE

330 Ft. From S Line NE
330 Ft. From E Line Quarter
 Ist. Report MAR 1 1953
 Completion
 Remarks
Salina Drlg. - Contr.
 Spudding Date 3-7-53

Drlg. Data

8" @ 325 WOC

I. G. McGEHEE

County Saline State Kansas

Sec. 26 (Blk. Twp.) 15 (Sur. Rge.) 4W Map No.

Operator M & H Pet.

Well No. 1 Farm Nelson

Elev. 1295 Location SE SE NE

330 Ft. From S Line NE
330 Ft. From E Line Quarter
 Ist. Report
 Completion APR 8 1953
 Remarks
Salina Drlg. - Contr.
 Spudding Date 3-7-53

Drlg. Data D & A TD 3416

8" @ 325 Miss. 2886 Kh. 3184

Misener 3316 Hunton 3317 Maq. sh. 3335

Maq. dol. 3413 DST 3414-16 open 3/4 hr.

Rec. 30' o & gcm 300' so & gcsw

180' gcsw 695# TD 3416

D & A

I. G. McGEHEE

Saline KANSAS ✓


Sec. 26 Twp. 15 R. 4 W

Well No. # 1 Nelson Farm

~~M & H PET~~
~~Salina Drlg~~ Company

Salina Drlg Contractor

Ft. from N. Line
330
Ft. from S. Line
330
Ft. from E. Line
Ft. from W. Line

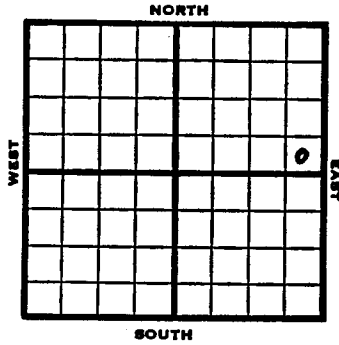

SE SE NE

1953 Elev. 1295' REPORT

3/11 Spud 3-7-53
8" @ 325' WOC

3/19 Re-cement surf.

3/26 Miss 2886, KH 3181, Miesner
3316, Htn 3317, Mq sha 3335
Drlg. 3380'

4/2 Mq Dol 3400'
DST 3401-05, 1 1/2 hrs, 150' muddy oil
60' oil. 1035#
TD 3405' 5" @ 3401

4/8 Spud 3-7-53
TD 3416'
8" @ 325'
Miss 2886, Kh 3181, Misener 3316,
Hunton 3317, Maq. sh 3335, Maq dol.
3413,
DST 3414-16 open 3/4 hr. Rec 30' o &
gcm 300' so & gcsw, 180' gcsw 695#
TD 3416'
D & A

ABANDONED

Saline KANSAS

Section 26 Township 15 Range 4W

Well No. #1 Nelson

Company M & H Petroleum

