

Saline

KANSAS

Sec. 26 Twp. 15 R. 4W

Well No. #2 Swenson Farm

E.K. Carey Company

Carey Drlg.-Contr. Contractor

Smolan Pool


Ft. from N. Line

330' Ft. from S. Line

Ft. from E. Line

990' Ft. from W. Line

SE SW SE

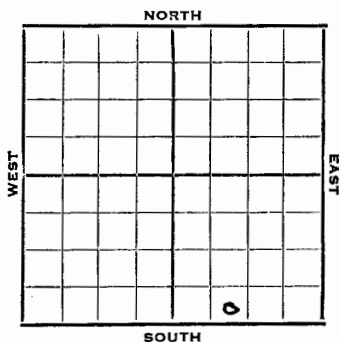


KANSAS

Section 26 Township 15 Range 4W

Well No. #2 Swenson

Company E. K. Carey

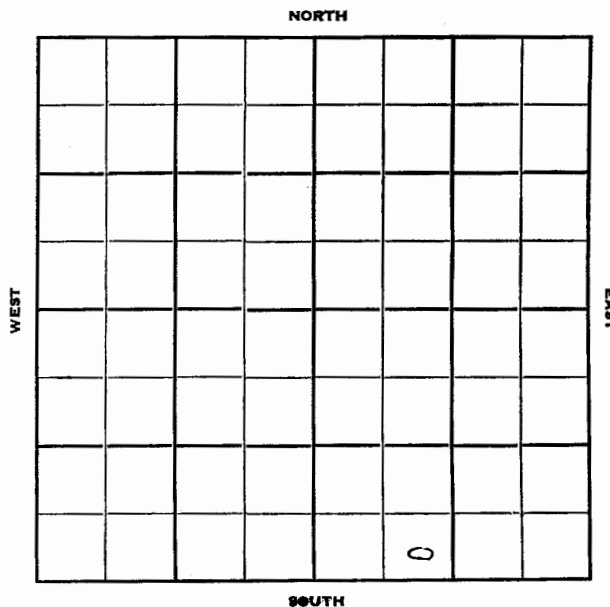

1951 Elev. 1305' REPORT

12/12 Spud 12-7-51
8" @ 315
Drlg. 1660'

1952 TD 3423 POP
2/6

2/13 Spud 12-7-51
Oil Well TD 3423
8" @ 315 Miss. 2912 Kh. 3182
Hun 3338 Ma.w. 3422 TD 3423
5" @ 3422 CO to 3423
S/ 4 boph Comp. 32 bopd 85% wtr.

COMPLETED