


County Saline State Kansas
 Sec. 26 (Blk. 15 (Sur. 4W Map No.
 Operator E. K. Carey
 Well No. 1 Farm Swenson
 Elev. _____ Location SE SE SE

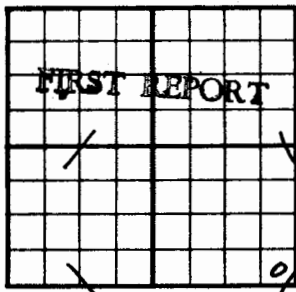


330 Ft. From S Line SE
330 Ft. From E Line Quarter
 1st. Report JUN 13 1951
 Completion _____
 Remarks _____
 Spudding Date 6-11-51

Drig. Data

8" @ 316' WOC Ryding Pool

J. E. TYRA

County Saline State Kansas
 Sec. 26 (Blk. 15 (Sur. 4W Map No.
 Operator E. K. Carey
 Well No. 1 Farm Swenson
 Elev. 1301 Location SE SE SE

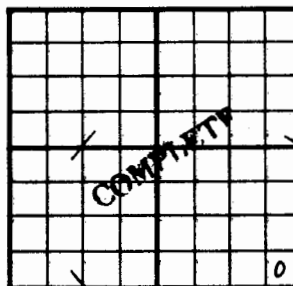

330 Ft. From S Line SE
330 Ft. From E Line Quarter
 1st. Report _____
 Completion AUG 1 1951
 Remarks Ryding Pool
 Spudding Date 6-11-51

Drig. Data Oil well TD 3413

8" @ 316 Burgess 2892 Miss. 2898
Kh. 3181 Misenor 3327 Hunton 3328
Mag. 3341 Dol. 3410 TD 3413 5" @ 3410
S/ 14 boph 500 A Comp. 1227 bopd

J. E. TYRA

Saline

KANSAS

Sec. 26 Twp. 15 R. 4 W

Well No. # 1 Swenson Farm

E. K. Carey Company

Contractor

Ryding Pool


Ft. from N. Line

330 Ft. from S. Line

330 Ft. from E. Line

Ft. from W. Line

SE SE SE

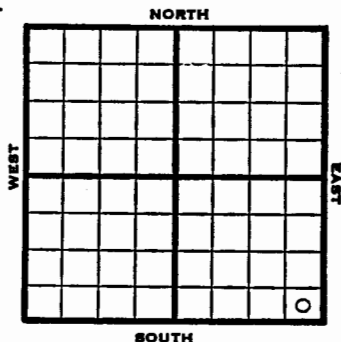

1951 Elev. 1301' REPORT

6/13 Spud 6-11-51
8" @ 316' WOC

8/1 Spud 6-11-51
Oil well TD 3413' 8" @ 316'
Burgess 2892' Miss 2898' Kh. 3181'
Misenor 3327' Hunton 3328' Maq. 3341
Dol 3410'
TD 3413' 5" @ 3410' S/14 BOPH
500 A
Comp. 1227 BOPD

COMPLETED

Saline KANSAS

Section 26 Township 15 Range 4W

Well No. #1 Swenson

Company E. K. Carey

