

Sec. 34 Twp. 15 R. 4W

Well No. #1 Carlson Farm

J. A. Melland Company

Melland - Contr. Contractor

Wildcat


990' Ft. from N. Line

_____ Ft. from S. Line

_____ Ft. from E. Line

330' Ft. from W. Line


SW NW NW

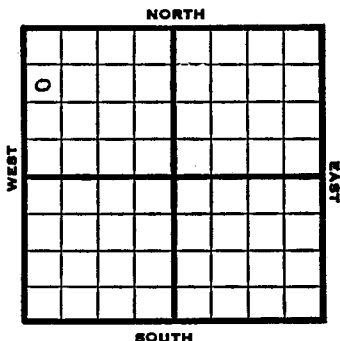

Section 34 Township 15 Range 4W

Well No. #1 Carlson

Company J. A. Melland

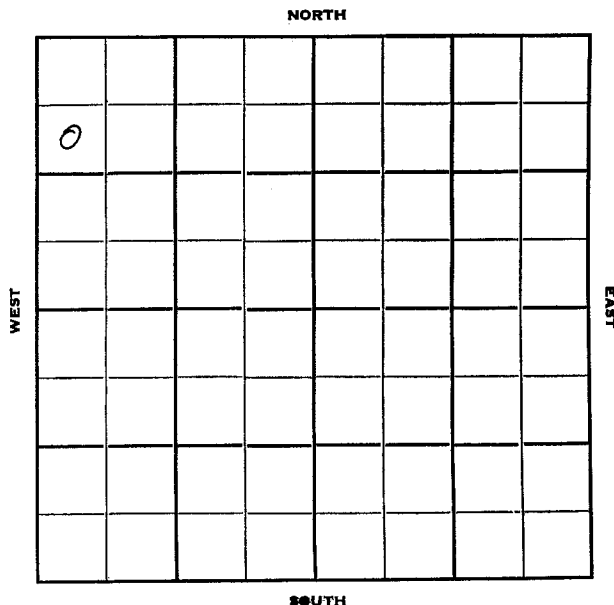

1951 Elev. 1350 REPORT

5/23 RUR

6/20 Spud 5-25-51

D&A TD 3798

8" @ 338

Miss 3108 Kh 3420

Misenor 3566 Hunton 3569

Maq. 3576 Dol. 3641

DST 3641-48 opn 40 min.

Rec. 230' mud & wtr Viola 3692

Simp. 3715 Simp dol. 3794

TD 3798

D&A

ABANDONED