



Saline

KANSAS

Sec. 34 Twp. 15 R. 4 W

Well No. # 1 Carlson Farm \_\_\_\_\_

Northwestern Drlg. Company \_\_\_\_\_

Contractor \_\_\_\_\_

**Wildcat**


\_\_\_\_\_ Ft. from N. Line

330 Ft. from S. Line

330 Ft. from E. Line

\_\_\_\_\_ Ft. from W. Line

SE SE SE

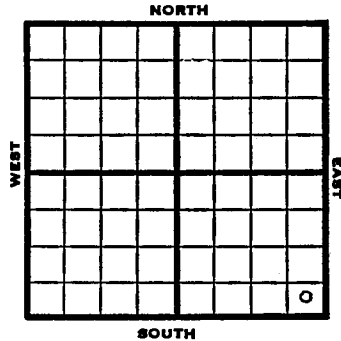


Saline

Section 34 Township 15 KANSAS 4W  
Range \_\_\_\_\_

Well No. #1 Carlson

Company Northwestern Drlg.

NORTH

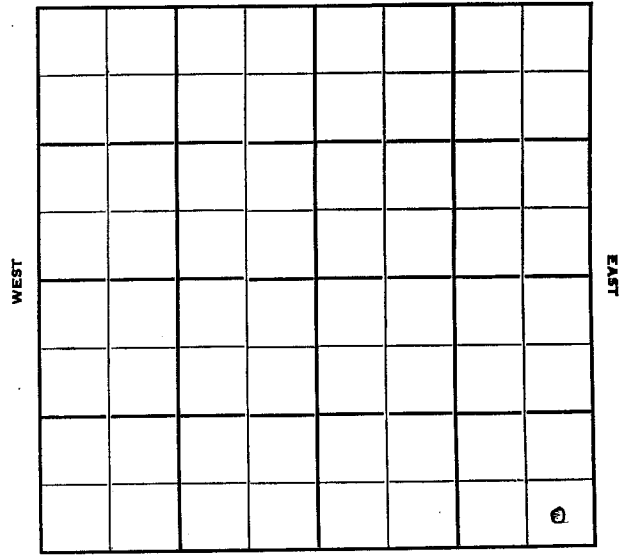

SOUTH

1951 Elev. 1315' REPORT

5/9 Location  
 6/13 Spud 5-21-51  
 D & A TD 3607' 8" @ 330  
 Miss 2948' Kinderhook 3180'  
 Viola 3437'  
 DST in Viola open 30 min. rec 900' SW  
 Hunton 3265' Maq. 3402'  
 DST 3438-41 open 1/2 hr. rec 1000' SW  
 Simp. dol. 3592' TD 3607'  
 D & A

**ABANDONED**