

Saline KANSAS

1952

Sec. 35 Twp. 15 R. 4 W

8/13 TD 3435 5" @ 3433 CO to 3435
S/4 boph Comp. 32 bopd
5% wtr.

Well No. # 2 Valin Farm

Shields Oil Prod. Company

Contractor

COMPLETED


Ft. from N. Line

330 Ft. from S. Line

330 Ft. from E. Line

Ft. from W. Line

SE SE SW

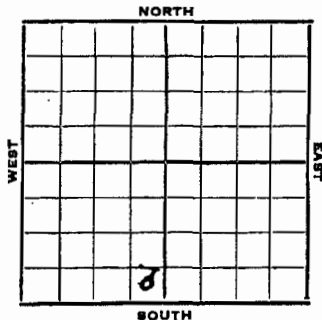

1952 Elev. 1322' REPORT

4/23 Location

4/30 NR

5/7 8" @ 344' Topoka 1810'
Drlg. 2050'

5/14 Miss 2907 KH 3153 Meisner 3369
Htn 3372 Mq Sh 3380
Mq Dol 3433 RTD 3435
5" @ 3433

5/20 CO 3435' S/4 BOPH

5/28 NR

6/11 POP

6/18 NR

6/25 NR

7/2 P/25 BOPD

7/9 NR

7/17 "

7/23 "

7/30 "

8/6 "

8/13 Spud 5-1-52
Oil Well TD 3435' 8" @ 344'
Top. 1810 Miss. 2907
KH 3153 Mis. 3369
Hun 3372 Maq. sh. 3380
Mag. dol. 3433

OVER

Section 35 Township 15 Range 1W

Well No. #2 Valin

Company Shields Oil Prod.

