

Saline KANSAS ✓

Sec. 35 Twp. 15 R. 4 W

Well No. # 5 Oburg Farm

Republic Natural Company

Carey Drlg. Contractor


1320 Ft. from N. Line

_____ Ft. from S. Line

470 Ft. from E. Line

_____ Ft. from W. Line

C E/2 E/2 NE

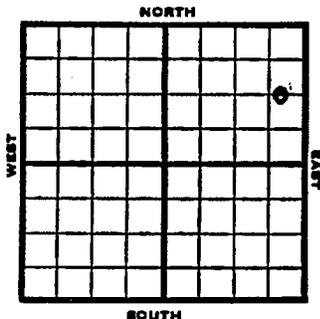

#5 Oburg
 1 (Information Brought Forward)
 1953
 4/29 24/3416-20, 1000A
 S/9 bo 2 bwph
 Comp. 114 bopd 10% wtr.

COMPLETED

1953		REPORT
	Elev. 1303'	
2/11	Spud 2-5-53 8" @ 433 Drlg. 1076'	
2/19	Drlg. 3106'	
2/26	V 3409' Cored 3411-51, 40' RTD 3472' 5" @ 3472	
3/12	Pipe parted	
3/19	CO after re-cement pipe	
3/26	24/3416-20, 1000A, S/9 BO + 2 BWPB	
4/2	"	
4/9	NR	
4/16	NR	
4/23	NR	
4/29	Spud 2-5-53 Oil Well TD 3475 8" @ 433 Kh 3188, Hunton 3332, Maq 3340, Viola 3415 TD 3475 5" @ 3472	

OVER

FORM 51

Saline

KANSAS

Section 35 Township 15 Range 4W

Well No. #5 Oburg

Company Republic Natural

