


County Saline State Kansas
 Sec. 35 (Blk. 15 (Sur. 4W Map No.

Operator E. K. Carey

Well No. 4 Farm Oberg

Elev. Location NE SW NE

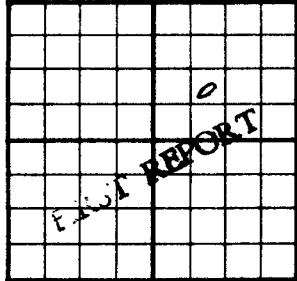

990 Ft. From S Line NE

990 Ft. From W Line Quarter

1st. Report JAN 30 1952

Completion

Remarks

Carey - Contr.

Spudding Date 1-26-52

Drlg. Data

8" @ 321 Drlg. 1450


J. G. McGEHEE

County Saline State Kansas
 Sec. 35 (Blk. 15 (Sur. 4W Map No.

Operator E. K. Carey

Well No. 4 Farm Oberg

Elev. 1312 Location NE SW NE

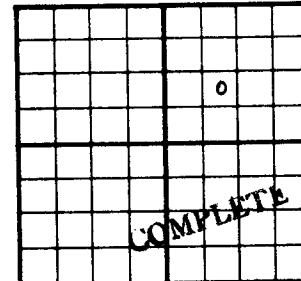

990 Ft. From S Line NE

990 Ft. From W Line Quarter

1st. Report

FEB 27 1952

Completion

Remarks

Carey Drlg. - Contr.

Spudding Date 1-26-52

Drlg. Data Oil well TD 3423

8" @ 321 KC 2250 Miss. 2915

Kh. 3196 Hunton 3340 Dol. 3422-23

4" @ 3422 TD 3423 S/ 3 boph 1 hr.

S/ 4 1/2 boph 2nd hr. S/ 28 bo 7 hr.

3500 A Comp. 501 boph

J. G. McGEHEE

Saline KANSAS

Sec. 35 Twp. 15 R. 4 W

Well No. # 4 Oberg Farm

E. K. Carey Company

Carey Contractor


Ft. from N. Line

990 Ft. from S. Line

Ft. from E. Line

990 Ft. from W. Line

NE SW NE

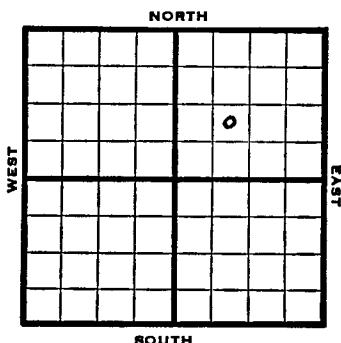


KANSAS

Section 35 Township 15 Range 4 W

Well No. # 4 Oberg

Company E. K. Carey

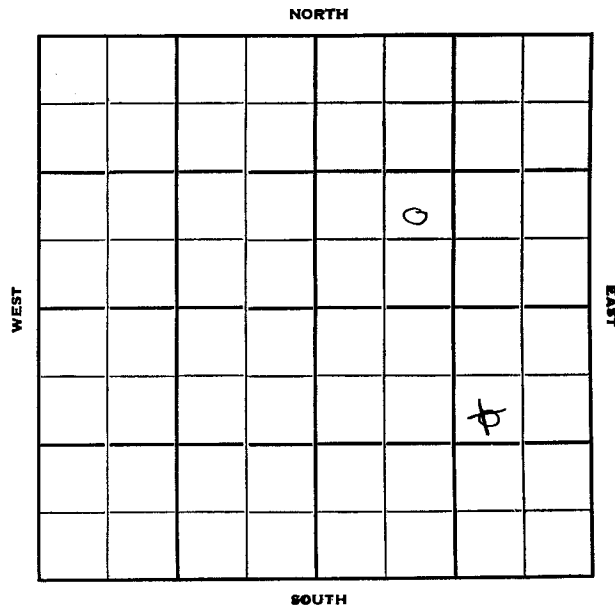

1952	Elev. 1312' REPORT
1/30	Spud 1-26-52 8" @ 321' Drlg. 1450'
2/6	KC 2250 Miss 2915 Drlg. 3375'
2/13	KH 3196 Htn 3340 Dolo 3422-23 TD 5" @ 3422 WOC
2/20	CO to 3423' S/3 BOPH for 1 hr. S/4 1/2 BOPH 2nd hr. S/28 BO in 7 hr. POP
2/27	Spud 1-26-52 Oil Well TD 3423 8" @ 321' KC 2250 Miss. 2915 Kh. 3196 Hun 3340 Dol. 3422-23 4" @ 3422 TD 3423 S/ 3 boph 1 hr. S/ 4 1/2 boph 2nd hr. S/ 28 bo 7 hr. 3500 A Comp. 501 bopd
COMPLETED	