



Saline

KANSAS

Sec. 35 Twp. 15 R. 4W

Well No. #3 Oberg Farm

E. K. Carey Company

Carey Contractor

Smolan


330 Ft. from N. Line

Ft. from S. Line

Ft. from E. Line

990 Ft. from W. Line

NE NW NE

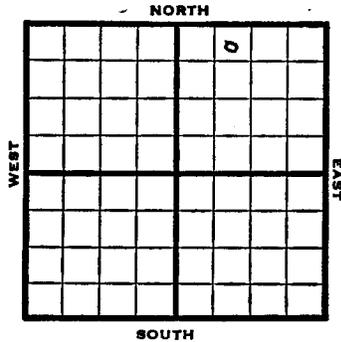


Saline KANSAS

Section 35 Township 15 Range 4 W

Well No. # 3 Oberg

Company E. K. Carey

NORTH

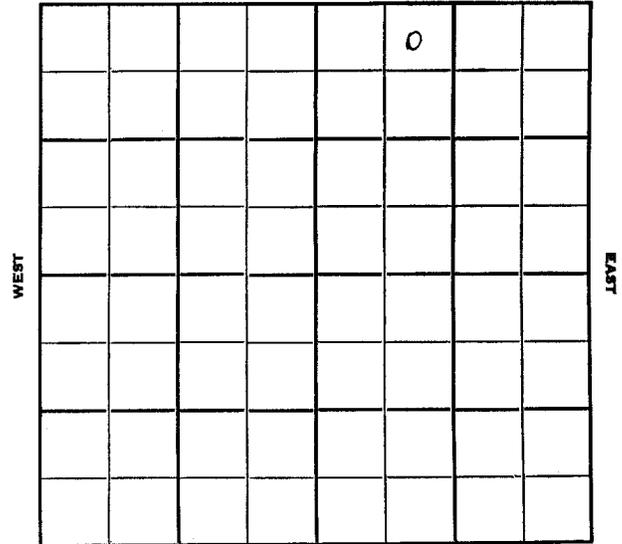

SOUTH

1951 Elev. 1306 REPORT

11/7 Location

12/19 Spud 11-7-51

Oil Well TD 3421

8" @ 305

Miss. 2912 Kh. 3192

Hunton 3338 Maq. sh 3348

Maz. dol. 3420-21

5" @ 3420 CO to 3421

S/ 9 BOPH 250 A

Comp. 309 BOPD 25% wtr.

COMPLETED