

County	Saline		State	Kansas	
Sec.	35	(Blk. Twp.) 15	(Sur. Rge.) 4W	Map No.	
Operator	E. K. Carey				
Well No.	2	Farm	Oborog		
Elev.			Location	SE SE NE	
			330 Ft. From S Line NE		
			330 Ft. From E Line Quarter		
			1st. Report SEP 12 1951		
			Completion		
			Remarks Carey Drlg. - Contr.		
			Spudding Date 9-10-51		
Drlg. Data			Smolan Pool		
8" @ 327 WOC					

J. E. TYRA

County	Saline		State	Kansas	
Sec.	35	(Blk. Twp.) 15	(Sur. Rge.) 4W	Map No.	
Operator	E. K. Carey				
Well No.	2	Farm	Oborog		
Elev.	1307	Location		SE SE NE	
			330 Ft. From S Line NE		
			330 Ft. From E Line Quarter		
			1st. Report		
			Completion NOV 28 1951		
			Remarks Smolan Pool		
			Spudding Date 9-10-51		
Drlg. Data			Oil well TD 3421		
8" @ 327 Miss. 2900 Kh. 3192					
Hunton 3340 Maq. 3348 Maq. dol. 3419					
TD 3421 5" @ 3420 CO to 3421					
S/ 15 boph Comp. 254 bopd 39% water					

J. E. TYRA

Saline

KANSAS

Sec. 35 Twp. 15 R. 4 W ✓

Well No. # 2 Oborog Farm

E. K. Carey Company

Carey Drlg. Contractor

Smolan Pool


 Ft. from N. Line

330 Ft. from S. Line

330 Ft. from E. Line

 Ft. from W. Line

SE SE NE

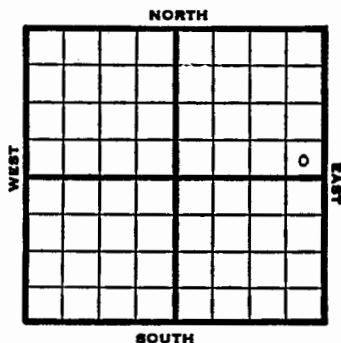

1951 Elev. 1307' REPORT

9/12 Spud 9-10-51
8" @ 327 WOC

11/28 Spud 9-10-51
Oil well TD 3421
8" @ 327
Miss 2900 Kh. 3192
Hunton 3340 Maq. 3348
Mag. dol. 3419
TD 3421
5" @ 3420 CO to 3421
S/ 15 BOPH
Comp. 254 BOPD 39% wtr.

COMPLETED

KANSAS

Section 35 Township 15 Range 4W

Well No. #2 Oborog

Company E. K. Carey

