

Kansas

County Saline State Kansas
Sec. 35 (Blk.) 15 (Sur.) 4N Map No.
Operator Ostenberg Oil
Well No. 1 Farm Newman
Elev. _____ Location SE NE NW

0
FIRST REPORT

990	Ft. From H	Line	NW
330	Ft. From B	Line	Quarter
1st. Report OCT 17 1951			
Completion			
Remarks			
Mallard - Contr.			
Spudding Date 10-14-51			

Drig. Data **Smolan**

8th @ 365

Map No. _____ Sec. 35 Twp. 15 R. 4W
Well No. 1 Newman
Ostenberg Oil Company
CORRECTION
SW NW NE _____ Contractor

SECTION PLAT

1150 Ft. from N. Line
 _____ Ft. from S. Line
 _____ Ft. from E. Line
120 Ft. from W. Line

		o	

Saline County

Location

Rig up.

Drilling and Remarks:

Reported

SE NE NW

RECORD

Cased _____ in., _____ ft.
 Sand _____
 Gas _____
 Oil _____
 Total Depth _____

PRODUCTION

1st 24 hrs. Nat. _____
1st 24 hrs. after shot _____
Gas _____ Cu. Ft.
Dry Hole _____
Abandoned _____

Date _____

OCT 31 19

J. E. TYRA Scout

J. E. TYRA

[illegible]

Saline

KANSAS

Sec. 35 Twp. 15 R. 4W

Well No. #1 Newman Farm

Ostenberg Oil Company

Mallard -Contr. Contractor


1150
990' Ft. from N. Line

Ft. from S. Line

330' Ft. from E. Line

120 Ft. from W. Line

SE NE NW
SW NW NE

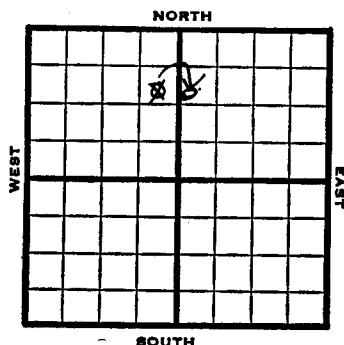

1951 Elev. 1308' REPORT

10/17 Spud 10-14-51
8" @ 365'

12/5 Spud 10-14-51
Oil Well TD 3425
8" @ 365'

Miss. 2922 Hunton 3343

Viola 3420

TD 3423 5" @ 3420

Mag. 3420 CO to 3423 DD 3425

PB 3421 64/ 3420-21 750 A

FU 650' oil 15 min.

Comp. 101 BOPD 72% wtr.

COMPLETED

KANSAS

Section 35 Township 15 Range 4W

Well No. #1 Newman

Company Ostenberg Oil

