


Saline KANSAS

SEC.	TWP.	R.
35	15	1W
WELL NO. 4 Liljestrand FARM		
COMPANY Derby Oil		
CONTRACTOR		

Smolan Pool

_____ Ft. from N. Line
 1320 _____ Ft. from S. Line
 990 _____ Ft. from E. Line
 _____ Ft. from W. Line

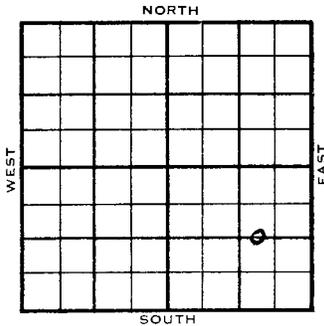

C W $\frac{1}{2}$ E $\frac{1}{2}$ SE

	ELEVATION	REPORT
1954	1324'	
6/23		Location
6/30		8" "
7/7		8" @ 346' w/250 sks Drlg. 2275'
8/25		Spud 6-29-54 - Oil Well TD 3442' 8" @ 346' Miss 2914', Kh. 3212', Maq. dol. 3439', TD 3442' 5" @ 3439' CO 8 bo 5 bw 11 hrs., 300A S/14 $\frac{1}{2}$ bo 10 bw 2000A S/25 bo 4.1 bw 14 hrs. S/1 bo 3 $\frac{1}{2}$ bwph 1500A S/10 boph 2 hrs., S/19 bo 3.4 bw 8 hrs. P/23 bo 40 bw 8 hrs. Comp. 78 bopd 51% wtr.
COMPLETED		

DX-78

Saline KANSAS

DX 78-1

Section 35 Township 15 Range 1W
 Well No. 4 Liljestrand
 Company Derby Oil

