

Saline

KANSAS

Sec. 35 Twp. 15 R. 4W

Well No. #3 Liljestrand Farm

Derby Oil Company

Carey Drlg. Contractor

Smolan Pool


330 Ft. from N. Line

_____ Ft. from S. Line

330 Ft. from E. Line

_____ Ft. from W. Line


NE NE SE

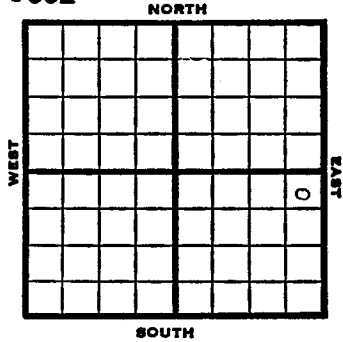

Section 35 Township 15 Range 4W

Well No. # 3 Liljestrand

Company Derby Oil

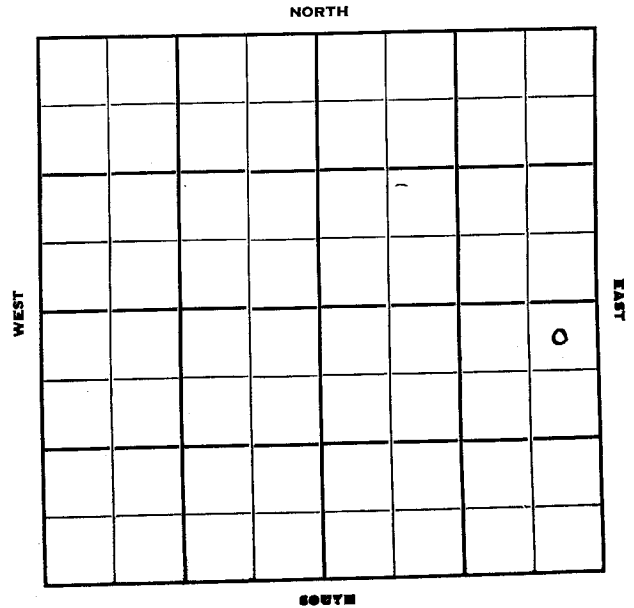

1951 Elev. 1320' REPORT

10/3 Cellar & pits
12/5 Spud 10-4-51
Oil well TD 3436
8" @ 319
Miss. 2920 Kh. 3206
Hunton 3356 Maq. 3362 Dol. 3434
TD 3436 4 1/2" @ 3435 CO to 3436
S/ 9 BO 60% wtr. 1 hr.
FU 1586' wtr. 750' oil
15 hr. P/ 14 BO 38 BW 8 hr.
Comp. 104 BOPD 67% wtr.

COMPLETED