

County Saline State Kansas

Sec. 35 (Blk. 15 (Sur. 4W Map No.

Operator Derby Oil

Well No. 2 Farm Lillystrand

Elev. 1323 Location SW SE SE

330	Ft. From	S	Line	SE
990	Ft. From	E	Line	Quarter
1st. Report <u>AUG 8 1951</u>				
Completion <u> </u>				
Remarks <u>Carey Drlg. - Contr.</u>				
Spudding Date <u> </u>				

Drig. Data Smolan Pool

Location

J. E. TYRA

County Saline State Kansas

Sec. 35 (Blk. 15 (Sur. 4W Map No.

Operator Derby Oil

Well No. 2 Farm Lillystrand

Elev. 1323 Location SW SE SE

330	Ft. From	S	Line	SE
990	Ft. From	E	Line	Quarter
1st. Report <u> </u>				
Completion <u>AUG 24 1951</u>				
Remarks <u>Smolan Pool</u>				
Carey Drlg. - Contr.				
Spudding Date <u> </u>				

Drig. Data Oil well TD 3461

8" @ 345 Maq. 3432 TD 3451 4" @ 3449

DD 3453 FU w/ SSO & 90' water 12 hr.

DD 3461 10/ 3432-33 FU 2450' oil

350' water 16 hr. S/ 3 bf 1 hr. 1% water

S/ 5 bf 2 hr. 6% water P/ 8 boph

P/ 99 bf 18 hr. 3% water 200 A

Miss. 2913 Kh. 3206 Hunton 3358

Maq. 3370 Comp. 693 bopd 3% water

J. E. TYRA

Saline

KANSAS

Sec. 35 Twp. 15 R. 4 W

Well No. # 2 Lillystrand Liljestrand Farm

Derby Oil Company

Carey Drlg. Contractor
Smolan Pool


Ft. from N. Line

330 Ft. from S. Line

990 Ft. from E. Line

Ft. from W. Line

SW SE SE

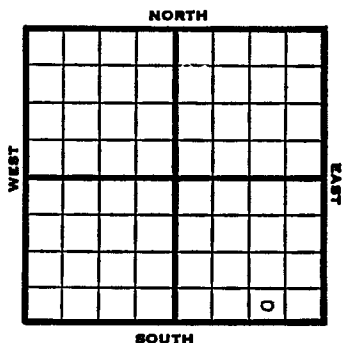

1951 Elev. 1323' REPORT

8/8 Location

10/24 Spud -
Oil Well TD 3461
8" @ 345
Mag. 3432 TD 3451
8" @ 3449 DD 3453
FU w/ SS & 90' wtr. 12 hr.
DD 3461 10/ 3432-33 FU 2450' oil
350' wtr. 16 hr. S/ 3 BF 1 hr.
1% wtr. S/ 5 BF 2 hr. 6% wtr.
P/ 8 BOPH P/ 99 BF 18 hr. 3% wtr.
200 A
Miss. 2913 Kh. 3206 Hunton 3358
Mag. 3370
Comp. 693 BOPD 3% wtr.

COMPLETED

Section 35 Township 15 Range 4W

Well No. #2 Lillystrand Liljestrand

Company Derby Oil

