


County **Saline** State **Kansas**  
 Sec. **35** (Blk. Twp.) **15** (Sur. Rge.) **4W** Map No.

Operator **Derby Oil**

Well No. **1** Farm **Liljestrand**

Elev. Location **SE SE SE**

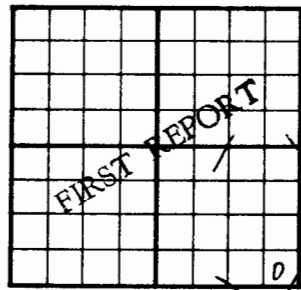

**330** Ft. From **S** Line **SE**

**330** Ft. From **E** Line Quarter

1st. Report **JUN 6 1951**

Completion

Remarks

**Carey Drlg. - Contr.**

Spudding Date

Drlg. Data

**Ryding Pool**

**R U R**

**J. E. TYRA**


County **Saline** State **Kansas**

Sec. **35** (Blk. Twp.) **15** (Sur. Rge.) **4W** Map No.

Operator **Derby Oil**

Well No. **1** Farm **Liljestrand**

Elev. **1326** Location **SE SE SE**

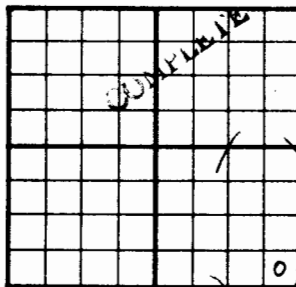

**330** Ft. From **S** Line **SE**

**330** Ft. From **E** Line Quarter

1st. Report

Completion **JUL 18 1951**

Remarks **Ryding Pool**

**Carey Drlg. - Contr.**

Spudding Date

Drlg. Data **Oil well TD 3437**

**Miss. 2916 Kh 3208 Maq. 3435-37**

**4 1/2" @ 3436 TD 3437 S/ 13 boph 300A**

**P/ 19 boph Comp. 1381 bopd**

**J. E. TYRA**

Saline KANSAS

Sec. 35 Twp. 15 R. 4W

Well No. #1 Liljestrand Farm

Derby Oil Company

Carey Drlg. - Contr. Contractor

Ryding Pool


         Ft. from N. Line

330' Ft. from S. Line

330' Ft. from E. Line

         Ft. from W. Line

SE SE SE

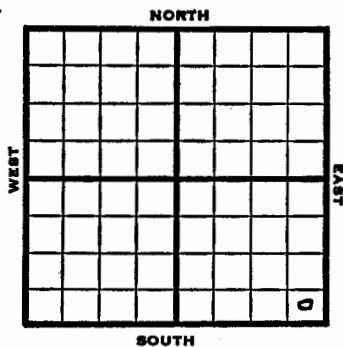

1951 Elev. 1326' REPORT

6/6 RUR

7/18 Oil well TD 3437'  
Miss 2916' Kh 3208' Maq. 3435-37'  
4 1/2" @ 3436' TD 3437' S/13 BOPH  
300 A P/19 BOPH  
Comp. 1381 BOPD

COMPLETED

Saline KANSAS

Section 35 Township 15 Range 4W

Well No. #1 Liljestrand

Company Derby Oil

