

Saline KANSAS

SEC. 35 TWP. 15 R. 4 W


WELL NO. # 4 Larson FARM

COMPANY El Dorado Ref.

CONTRACTOR Sterling Drlg. Smolan Pool

330 Ft. from N. Line
 Ft. from S. Line
 Ft. from E. Line
 990 Ft. from W. Line

NE NW SE

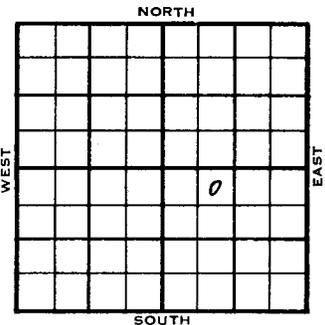

ELEVATION	REPORT
1954	1316'
3/24	Spud 3-21-54 8" @ 374 WOC
3/31	Drlg. 2970'
4/7	Miss 2907' KH 3199 Mq 3424 RTD 3427 5" @ 3425
5/12	Spud 3-21-54 Oil well TD 3427 8" @ 374 Miss 2907' Kh. 3199 Maq. 3424 TD 3427 5" @ 3425 CO to 3427 FU 600' hvy oil 16 hr. S/dry FU 55' oil 55' wtr. 1 hr. S/1 1/4 BO 1 BWP 6 hr. 300 A S/1 1/2 BO 2 BWP Comp. 66 BOPD 13% wtr.
COMPLETED	

DX-78

FORM 51

Saline KANSAS

Section 35 Township 15 Range 4 W

Well No. # 4 Larson

Company El Dorado Ref.

