

County Saline State Kansas

Sec. 35 (Blk. Twp.) 15 (Sur. Rge.) 4W Map No. _____

Operator Elraco

Well No. 3 Farm Larson

Elev. _____ Location C W/2 W/2 SE

1520 Ft. From S Line SE

330 Ft. From W Line Quarter

1st. Report JUN 25 1952

Completion _____

Remarks Shields - Contr.

Spudding Date 6-21-52

Drig. Data _____

8" @ 351

J. G. McGEHEE

County	Saline		State	Kansas	
Sec.	35	(Bik. Twp.)	15	(Sur. Rge.)	4W Map No.
Operator	Elreco				
Well No.	3	Farm	Larson		
Elev.	1313	Location	C W ¹ / ₂ W ¹ / ₂ SE		
			1320 Ft. From S Line SE		
			330 Ft. From W Line Quarter		
			1st. Report		
			Completion AUG 6 1952		
Remarks			Shields - Contr.		
Spudding Date			6-21-52		
Drig. Data	Oil well		TD 3421		

J. G. McGEHEE

Saline

KANSAS
4W

Sec. 35 Twp. 15 R.

Well No. #3 Larson Farm

Elreco Company

Shields Contractor

Ft. from N. Line

1320


Ft. from S. Line

Ft. from E. Line

330

Ft. from W. Line

C W/2 W/2 SE

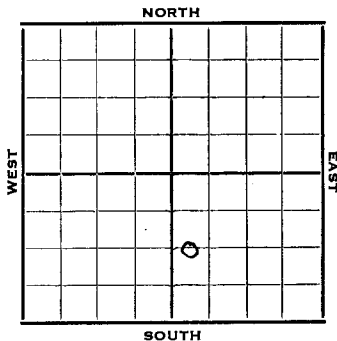


Saline KANSAS

Section 35 Township 15 Range 4 W

Well No. # 3 Larson

Company Elreco

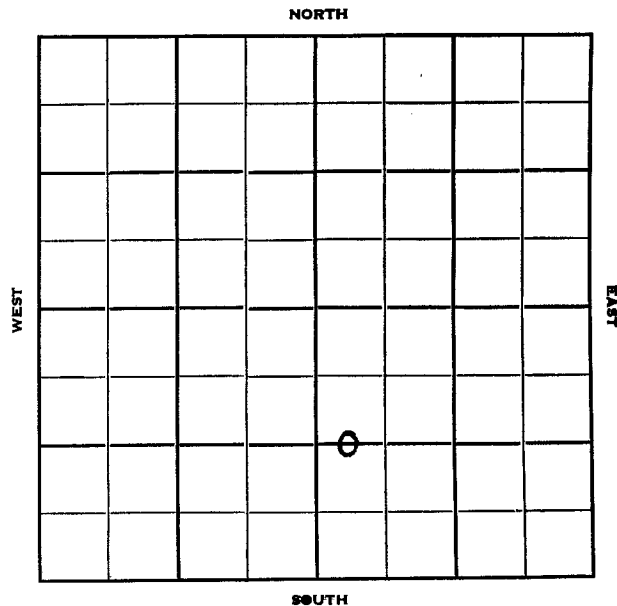

1952 Elv. 1313'

REPORT

6/25 Spud 6-21-52
8" @ 351'

7/2 Drlg. 3021'

7/9 NR

7/17 KH 3191 Mq Dol 3419
RTD 3420 5" @ 3419
DP CO 3420 Fill up 75' oil
DD 3421 fill up 2000' oil 16 hrs.
S/7 Boph for 3 hrs. POP

7/23 NR

7/30 NR

8/6 Spud 6-21-52
Oil well TD 3421' 8" @ 351
Kh. 3191' Maq. 3419'
TD 3420' 5" @ 3419' CO to 3420'
FU 75' oil DD 3421' FU 200' oil
16 hr. S/7 BOPH
Comp. 140 BOPD

COMPLETED