

County Saline State KANSAS
 Sec. 35 (Blk. 15) (Sur. 4W) Map No. 4W
 Operator Elreco Ref.
 Well No. 2 Farm Larson
 Elev. 1330 Location SW SW SE

330 Ft. From S Line SE
330 Ft. From W Line Quarter
 1st. Report JUN 11 1952
 Completion
 Remarks Shields - Contr.
 Spudding Date 6-7-52
 Drlg. Data Smolan Pool
8" @ 358 drlg. 820

J. G. McGEHEE

County Saline State Kansas
 Sec. 35 (Blk. 15) (Sur. 4W) Map No. 4W
 Operator Elreco Ref.
 Well No. 2 Farm Larson
 Elev. 1330 Location SW SW SE

330 Ft. From S Line SE
330 Ft. From W Line Quarter
 1st. Report
 Completion AUG 13 1952
 Remarks Smolan Pool
Shields - Contr.
 Spudding Date 6-7-52
 Drlg. Data Oil well TD 3440
8" @ 358 Ft. Riley 1700 KC 2400
 Miss. 2948 Kn. 3209 Maq. dol. 3438
 TD 3440 5" @ 3439 CO to 3440 FU 800'
 oil 7 hr. S/ 4 boph 3 hr.
 Comp. 124 bopd

J. G. McGEHEE

Saline

KANSAS

Sec. 35 Twp. 15 R. 4W

Well No. #2 Larson Farm

Elreco Ref. Company

Shields - Contr. Contractor
Smolan Pool


Ft. from N. Line

330' Ft. from S. Line

Ft. from E. Line

330' Ft. from W. Line

SW SW SE

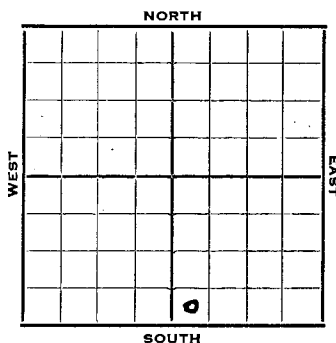

1952 Elev. 1330' REPORT

6/7 Spud 6-7-52
8" @ 358
Drlg. 820'

6/11 "

6/18 Ft. Riley 1700 KC 2400
Miss 2900 Drlg. 3048'

6/25 (Corr: Miss 2948') KH 3209'
Mq Dol 3438' RTD 3440'
5" @ 3439'

7/2 CO 3440 fill up 800' oil 7 hrs.
S/4 Boph for 3 hrs. tub & rods

7/9 NR

7/17 "

7/23 "

7/30 "

8/6 "

8/13 Spud 6-7-52
Oil Well TD 3440' 8" @ 358
Ft. Riley 1700 KC 2400
Miss. 2948 Kh. 3209
Maq. dol. 3438
TD 3440 5" @ 3439 CO to 3440
FU 800' oil 7 hr. S/4 boph
3 hr. Comp. 124 bopd

COMPLETED

Saline

KANSAS

Section 35 Township 15 Range 4 W

Well No. # 2 Larson

Company Elreco Ref.

