


County Saline State Kansas
 Sec. 35 (Blk. 15 (Sur. 4W Map No.
 Operator Eldorado Ref.
 Well No. 1 Farm Larson
 Elev. _____ Location SE SW SE

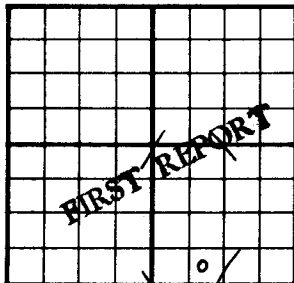


330 Ft. From S Line SE
990 Ft. From W Line Quarter
 1st. Report JUL 18 1951
 Completion _____
 Remarks _____
Sterling Drlg. - Contr.
 Spudding Date 7-15-51

Drlg. Data Smolan Pool
13" @ 105

J. E. TYRA

County Saline State Kansas
 Sec. 35 (Blk. 15 (Sur. 4W Map No.
 Operator Eldorado Ref.
 Well No. 1 Farm Larson
 Elev. 1331 Location SE SW SE

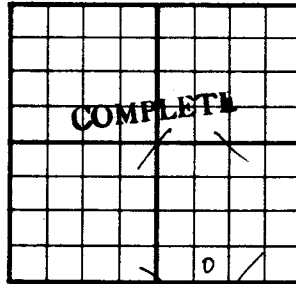

330 Ft. From S Line SE
990 Ft. From W Line Quarter
 1st. Report _____
 Completion AUG 29 1951
 Remarks Smolan Pool
Sterling Drlg. - Contr.
 Spudding Date 7-15-51

Drlg. Data Oil well TD 3442
13" @ 105 Mag. dol. 3438 DST 3439-42
open 1/2 hr. Rec. 450' oil 5" @ 3439
TD 3442 FU 3000' oil 12 hr.
Comp. 183 bopd 18% water

J. E. TYRA

Saline

KANSAS

Sec. 35 Twp. 15 R. 4 W

Well No. # 1 Larson Farm

El Dorado Ref. Company

Sterling Drlg. Contractor

Smolan Pool


Ft. from N. Line

330 Ft. from S. Line

Ft. from E. Line

990 Ft. from W. Line

SE SW SE

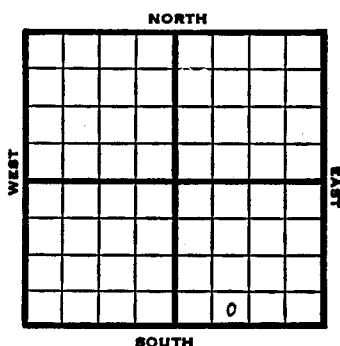

1951 Elev. 1331' REPORT

7/18 Spud 7-15-51
13" @ 105'

8/29 Spud 7-15-51
Oil Well TD 3442
13" @ 105
Maq. dol 3438
DST 3439-42 opn $\frac{1}{2}$ hr
Rec. 450' oil 5" @ 3439
TD 3442 FU 3000' oil 12 hr.
Comp. 183 Bopd 18% wtr.

COMPLETED

Saline

KANSAS

Section 35 Township 15 Range 4W

Well No. 1 Larson

Company Eldorado Refg.

