

County Saline State Kansas  
Sec. 35 (Bik. Twp.) 15 (Sur. Rge.) 4W Map No.

Operator Fredricks etal.

Well No. 1 Farm Erickson

Elev. \_\_\_\_\_ Location NE NE NE

					0

330 Ft. From N Line NE

330 Ft. From E Line Quarter

Ist. Report MAY 9 1951

Completion \_\_\_\_\_

Remarks \_\_\_\_\_

Carey Drlg. - Contr.

Spudding Date \_\_\_\_\_

Drlg. Data \_\_\_\_\_

R U R

J. E. TYRA

County Saline State Kansas

Sec. 35 (Bik. Twp.) 15 (Sur. Rge.) 4W Map No.

Operator Fredricks etal.

Well No. 1 Farm Erickson

Elev. 1302 Location NE NE NE

					0

330 Ft. From N Line NE

330 Ft. From E Line Quarter

Ist. Report \_\_\_\_\_

Completion JUN 13 1951

Remarks Wildcat

Carey Drlg. - Contr.

Spudding Date 5-7-51

Drlg. Data Oil well TD 3416

8 5/8" @ 318 Miss. 2906 Maq. 3412

DST 3413-16 open 1/2 hr. Rec. 110'

ocm 450' ok 5" @ 3412

CO to 3416 S/ 16 1/2 boph 400' off

bottom 500 A Comp. 1182 bopd

J. E. TYRA

Saline

KANSAS

Sec. 35 Twp. 15 R. 4 W ✓

Well No. # 1 Erickson Farm

Fredricks et al Company

Carey Drlg. Contractor

Wildcat


330 Ft. from N. Line

\_\_\_\_\_ Ft. from S. Line

330 Ft. from E. Line

\_\_\_\_\_ Ft. from W. Line


NE NE NE

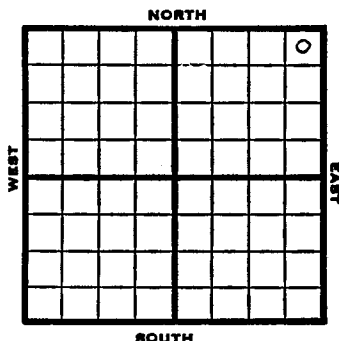

Section 35 Township 15 KANSAS Range 4W

Well No. #1 Erickson

Company Fredricks Etää

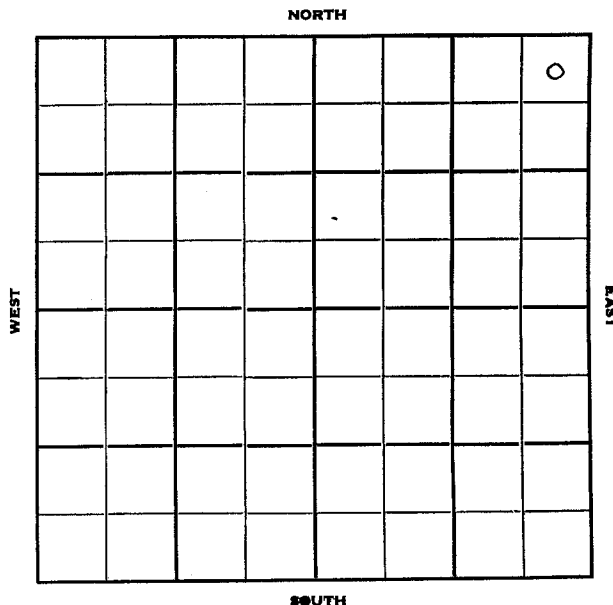

1951 Elev. 1302' REPORT

5/9 R U R

6/13 Spud 5-7-51  
 Oil well TD 3416' 8-5/8" ● 318  
 Miss. 2906' Maq. 3412'  
 DST 3413-16 open 1/2 hr. rec 110' OCM  
 450' oil  
 5" ● 3412 CO to 3416' S/16 1/2 BOPH  
 400' off bottom 500 A  
 Comp. 1182 BOPD

**COMPLETED**