



Saline KANSAS ✓

Sec. 36 Twp. 15 R. 4W


Well No. #7 Lofgren Farm

Republic Natural Company

Carey Drlg. Contractor

Smolan Pool

Ft. from N. Line

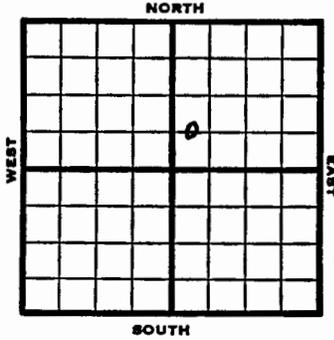

660 Ft. from S. Line

Ft. from E. Line

330 Ft. from W. Line

C W L SW NE


Saline KANSAS

Section 36 Township 15 Range 4W

Well No. # 7 Lofgren

Company Republic Natural

NORTH

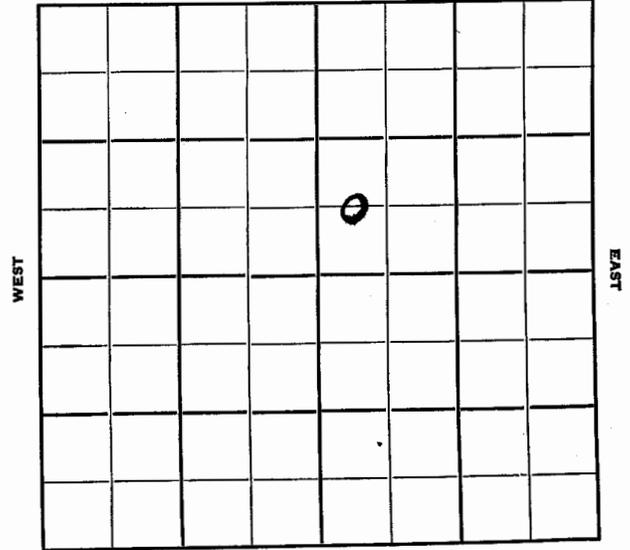

SOUTH

1953 Elev. 1306' REPORT

4/15 Spud 4-11-53  
15 1/2" @ 103'  
Drlg. 240'

4/23 Drlg. 2450'

4/30 V 3415  
RTD 3459  
7" @ 3459

5/7 CO 3459' 24/3418-22 2500 A  
S/3-1/3 BOPH 6 hrs.

5/21 NR

5/27 Spud 4-11-53  
Oil Well  
TD 3459'  
15 1/2" @ 103'  
Viola 3415',  
TD 3459'  
7" @ 3459'  
CO to 3459 24/ 3418-22 2500 A S/ 3  
1/3 boph 6 hr.  
Comp. 89 bopd 12% wtr.

COMPLETED