


County **Saline** State **Kansas**
 Sec. **36** (Blk. **15** (Sur. **4W** Map No.
 Operator **Republic Natural**
 Well No. **6** Farm **Lofgren**
 Elev. **1304** Location **C NW NE**

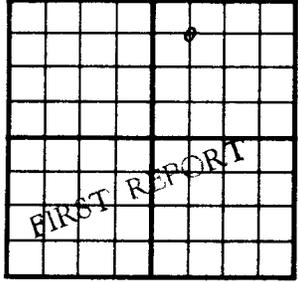


660 Ft. From **N** Line **NE**
660 Ft. From **W** Line **Quarter**
 1st. Report **MAR 18 1953**
 Completion _____
 Remarks _____
 Spudding Date _____

Drlg. Data **Smolan Pool**
 Location _____

J. G. McGEHEE

County **Saline** State **Kansas**
 Sec. **36** (Blk. **15** (Sur. **4W** Map No.
 Operator **Republic Natural**
 Well No. **6** Farm **Lofgren**
 Elev. **1304** Location **C NW NE**

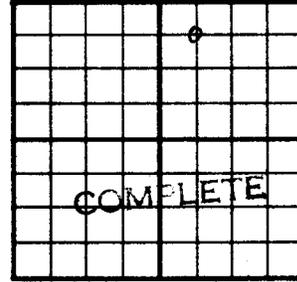

660 Ft. From **N** Line **NE**
660 Ft. From **W** Line **Quarter**
 1st. Report _____
 Completion **MAY 13 1953**
 Remarks **Smolan Pool**
 Spudding Date **3-30-53**

Drlg. Data **Oil well TD 3458**
10" @ 362 **Kn. 3179** **Hunton 3320**
Viola 3414 **TD 3458** **5" @ 3458**
CO to 3428 **18/ 3416-19** **S/ 31 boph**
1 bwph **1000 A** **Comp. 122 bopd** **3% wtr.**

J. G. McGEHEE

Saline KANSAS

Sec. 36 Twp. 15 R. 4 W

Well No. # 6 Lofgren Farm

Republic Natural Company

Contractor

Smolan Pool


660 Ft. from N. Line

Ft. from S. Line

Ft. from E. Line

660 Ft. from W. Line

C NW NE

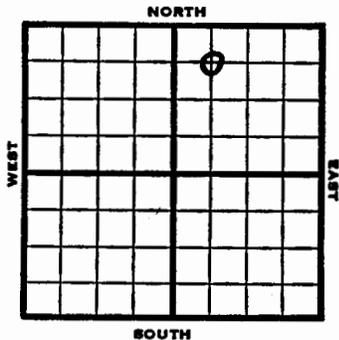

Saline


KANSAS

Section 36 Township 15 Range 4 W

Well No. #6 Lofgren

Company Republic Natural Gas Company

NORTH

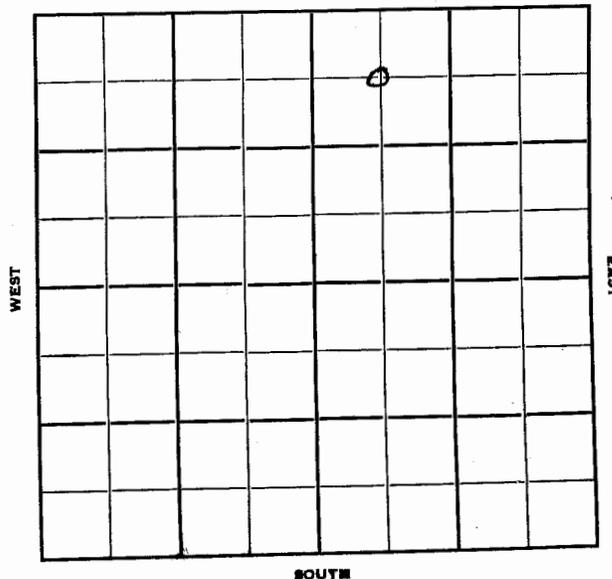

1953	Elev. 1304'	REPORT
3/18		Location
3/26		"
4/2		"
4/9	10" @ 362'	Drlg 2581'
4/16	Mq Dol 3417	RTD 3458
		5" @ 3458
4/23	CO 3428	18/3416-19, S/31 BO + 1 BWPH, 1000A POP
4/30	NR	
5/7	NR	
5/13	Spud 3-30-53	
	Oil Well	
	TD 3458'	
	10" @ 362'	
	Kh. 3179, Hunton 3320, Viola 3414	
	TD 3458	
	5" @ 3458'	
	CO to 3428	
	18/ 3416-19 S/ 31 boph	
	1 bwph 1000 A	
	Comp. 122 bopd	3% wtr. COMPLETED