

County	Saline	State	Kansas
Sec.	36 (Blk. Twp.)	15 (Sur. Rge.)	4W Map No.
Operator	Republic Natural Gas		
Well No.	5	Farm	Lofgren
Elev.	Location SE NE NE		
	990 Ft. From N Line NE		
	330 Ft. From E Line Quarter		
	1st. Report JAN 28 1952		
	Completion		
	Remarks		
	E.K. Carey - Contr.		
	Spudding Date		

Drig. Data Smolan Pool

R U R

J. G. McGEHEE

County	Saline	State	Kansas
Sec.	36 (Blk. Twp.)	15 (Sur. Rge.)	4W Map No.
Operator	Republic Natural Gas		
Well No.	5	Farm	Lofgren
Elev.	1299	Location SE NE NE	
	990 Ft. From N Line NE		
	330 Ft. From E Line Quarter		
	1st. Report		
	Completion MAR 25 1953		
	Remarks Smolan Pool		
	Carey Drlg. - Contr.		
	Spudding Date 1-27-53		

Drig. Data Oil well TD 3419

8" @ 350 Kh. 3177 Hunton 3320

Maq. 3335 Viola 3409 TD 3419

5" @ 3448 10/ 3413-15 FU 1800' wtr. &

mud PB 3417 23/ 3409-13 1000 A

S/ 35 bo 3 bw 4 1/2 hr. S/ 116 bopd

Comp. 127 bopd 2% wtr.

J. G. McGEHEE

Saline **KANSAS** ✓Sec. 36 Twp. 15 R. 4WWell No. #5 Lofgren Farm _____

Republic Natural Gas Company

E. K. Carey Contractor
Smolian Pool


990 Ft. from N. Line

Ft. from S. Line

330 Ft. from E. Line

Ft. from W. Line

SE NE NE

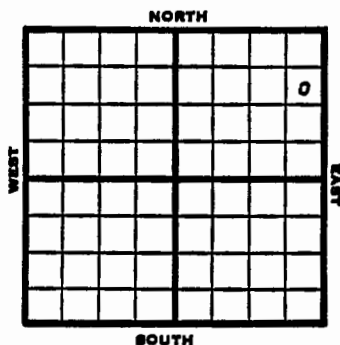

1953 Elev. 1299' REPORT

1/28 RUR

2/5 8" @ 350
Drlg. 1750'

2/12 V 3398' RTD 3448' 5" @ 3448

2/19 CO 3419' Elec. log. 10/3413-15
FU 1800' water & M Sq.2/26 PB 3417 23/3409-13 SO 1000 A
S/35 BO plus 3 BW 4½ hrs.

3/12 NR

3/19 S/116 BOPD plus trace wtr.

3/25 Spud 1-27-53

Oil Well

TD 3419

8" @ 350

Kh 3177, Hunton 3320, Maq.

3335, Viola 3409

TD 3419

5" @ 3448

10/3413-15, FU 1800' wtr & mud

PB 3417

23/3409-13, 1000A

S/35 bo 3 bw 4 ½ hrs.,

S/116 bopd

Comp. 127 bopd 2% wtr.

COMPLETED

FORM 51 Saline

KANSASSection 36 Township 15 Range 4WWell No. #5 LofgrenCompany Republic Natural Gas