

County Saline State Kansas

Sec. 36 (Blk.) 15 (Sur.) 4W Map No.

Operator E. K. Carey Drlg.

Well No. 4 Farm Bengstone

Elev. _____ Location SW SE NE

330 Ft. From S Line NE

990 Ft. From E Line Quarter

1st. Report MAR 5 1952


Completion _____

Remarks Carey - Contr.

Spudding Date 3-2-52

Drlg. Data Smolin

8" @ 325 W.O.C.

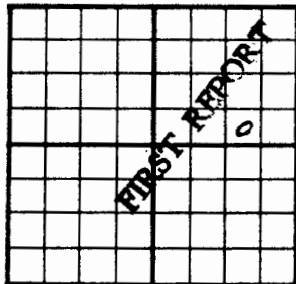

KANSAS

Map No. _____ Sec. 36 Twp. 15 R. 4W


Well No. 4 Lofgren

E. K. Carey Drlg. Company

CONTRACTOR Contractor

SW SE NE

SECTION PLAT

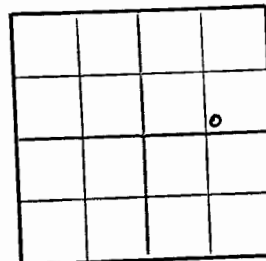

_____ Ft. from N. Line

330 Ft. from S. Line

990 Ft. from E. Line

_____ Ft. from W. Line

Saline County

Location _____

Rig up _____

Drilling and Remarks:

Reported

4 Bengstone

RECORD

Cased _____ in, _____ ft.

Sand _____

Gas _____

Oil _____

Total Depth _____

PRODUCTION

1st 24 hrs. Nat. _____

1st 24 hrs. after shot _____

Gas _____ Cu. Ft.

Dry Hole _____

Abandoned _____

Date


MAR 12 1952 19

J. G. McGEHEE

Scout

J. G. McGEHEE

County Saline State Kansas
 Sec. 36 (Bk. 15) (Sur. 4W) Map No.
 Operator E. K. Carey Drlg.
 Well No. 4 Farm Lofgren
 Elev. 1305 Location SW SE NE

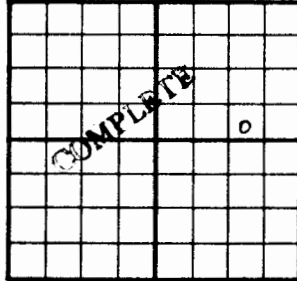

330 Ft. From S Line NE
990 Ft. From E Line Quarter
 Ist. Report
 Completion JUN 1 8 1950
 Remarks Smolan Pool
Carey Drlg. - Contr.
 Spudding Date 3-2-52

Drlg. Data Oil well TD 3423
8" @ 325 Miss. 2904 Kh. 3206
Hunton 3334 Maq. sh. 3344 Maq. dol. 3422
 TD 3423 5" @ 3422 CO to 3423 S/ 11 boph
500 A Comp. 223 bopd

J. G. McGEHEE

Saline

KANSAS ✓

Sec. 36 Twp. 15 R. 14WWell No. #1 Bengtson Farm

E. K. Carey Drlg.

Company

Contractor


Ft. from N. Line

330 Ft. from S. Line

990 Ft. from E. Line

Ft. from W. Line

SW SE NE

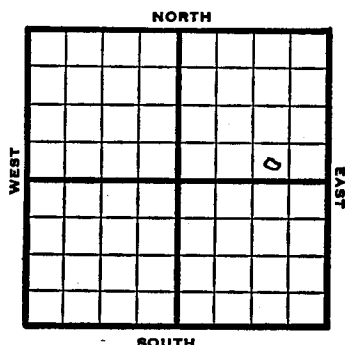

1952 Elev. 1305' REPORT

3/5 Spud 3-2-52
8" @ 325' WOC

3/11 Drlg. 2745'

3/19 Mq. Dol. 3422
5" @ 3422
RTD 2423 WOCT

3/25 Miss. 2904 Kh 3206
Htn. 3334 Mq. Sh 3344
Mq. dol. 3422 RTD 3423
5" @ 3422 Drlg. plug
CO to 3423 S/ 11 boph to POP

4/1 " "

4/9 " "

4/23 NR

4/30 POP

5/7 NR

5/14 " "

5/28 " "

5/28 " "

6/11 " "

6/18 Spud 3-2-52
Oil Well TD 3423' 8" @ 325
Miss. 2904 Kh. 3206
Hun 3334 Maq sh 3344
Maq dol. 3422
TD 3423' 5" @ 3422' CO to 3423
S/ 11 boph 500 A Comp. 223 bopd

COMPLETED

KANSAS

Section 36 Township 15 Range 14WWell No. #1 Bengtson L O F G R E NCompany E. K. Carey Drlg.