

County Saline State Kansas
 Sec. 36 (Blk. 15 (Sur. 4W Map No.
 Operator E. K. Carey
 Well No. 3 Farm Lofgren
 Elev. _____ Location SE SW NE

330 Ft. From S Line NE
990 Ft. From W Line Quarter
 Ist. Report NOV 14 1951
 Completion _____
 Remarks _____
 Spudding Date _____

Drlg. Data Smolan
Location

J. E. TYRA

County Saline State Kansas
 Sec. 36 (Blk. 15 (Sur. 4W Map No.
 Operator E. K. Carey
 Well No. 3 Farm Lofgren
 Elev. 1302 Location SE SW NE

330 Ft. From S Line NE
990 Ft. From W Line Quarter
 Ist. Report _____
 Completion FEB 13 1952
 Remarks Smolan Pool
 Spudding Date 12-23-51

Drlg. Data Oil well TD 3416
8" @ 315 Miss. 2900 Kh. 3190
Hunton 3328 Mag. 3414 TD 3416
5" @ 3414 CO to 3416 S/ 5 boph 1000 A
Comp. 386 bopd

J. G. McGEHEE

Saline KANSAS

Sec. 36 Twp. 15 R. 4 W
Well No. # 3 Lofgren Farm
E. K. Carey Company

Contractor

Smolan


Ft. from N. Line

330 Ft. from S. Line

Ft. from E. Line

990 Ft. from W. Line

SE SW NE

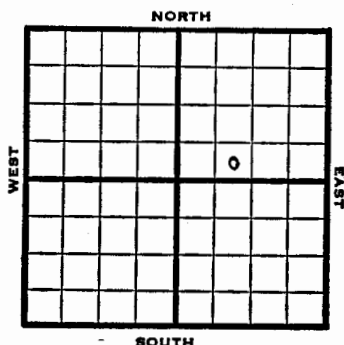

1951 Elev. 1302' REPORT

11/14 Location

1952

2/6

TD 3416 5" @ 3414 POP

2/13

Spud 12-23-51

Oil Well TD 3416

8" @ 315 Miss. 3900 Kh. 3190

Hun 3328 Maq. 3414 TD 3416

5" @ 3414 CO to 3416 S/ 5 boph

1000 A Comp. 386 bopd

COMPLETED

Saline KANSAS

Section 36 Township 15 Range 4W
Well No. #3 Lofgren
Company E. K. Carey

