

County Saline State Kansas

Sec. 36 (Blk. Twp.) 15 (Sur. Rge.) 4W Map No.

Operator E. K. Carey etal.

Well No. 1 Farm Lofgren

Elev. \_\_\_\_\_ Location NE NE NE


330 Ft. From N Line NE

330 Ft. From E Line Quarter

1st. Report JUL 25 1951

Completion \_\_\_\_\_

Remarks \_\_\_\_\_

Carey Drlg. - Contr.

Spudding Date \_\_\_\_\_

Drlg. Data \_\_\_\_\_ Smolan Pool

Location \_\_\_\_\_

J. E. TYRA

County Saline State Kansas

Sec. 36 (Blk. Twp.) 15 (Sur. Rge.) 4W Map No.

Operator E. K. Carey etal.

Well No. 1 Farm Lofgren

Elev. 1298 Location NE NE NE


330 Ft. From N Line NE

330 Ft. From E Line Quarter

1st. Report \_\_\_\_\_

Completion SEP 26 1951

Remarks Smolan Pool

Carey Drlg. - Contr.

Spudding Date 7-26-51

Drlg. Data Oil well TD 3409

8" @ 342 Miss. 2886 Kh. 3172

Misener 3318 Hunton 3322 Maq. sh. 3334

Maq. dol. 3406-08 5" @ 3406 TD 3409

FU 3008' oil 17 hr. 1000 A

Comp. 612 bopd

J. E. TYRA

Saline

KANSAS

Sec. 36 Twp. 15 R. 4 W

Well No. # 1 Lofgren Farm

E. K. Carey et al Company

Carey Drlg. Contractor

Smolan Pool


330 Ft. from N. Line

Ft. from S. Line

330 Ft. from E. Line

Ft. from W. Line

NE NE NE

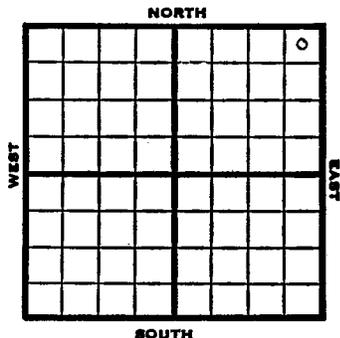


Saline KANSAS

Section 36 Township 15 Range 4W

Well No. 1 Lofgren

Company E. K. Carey et al

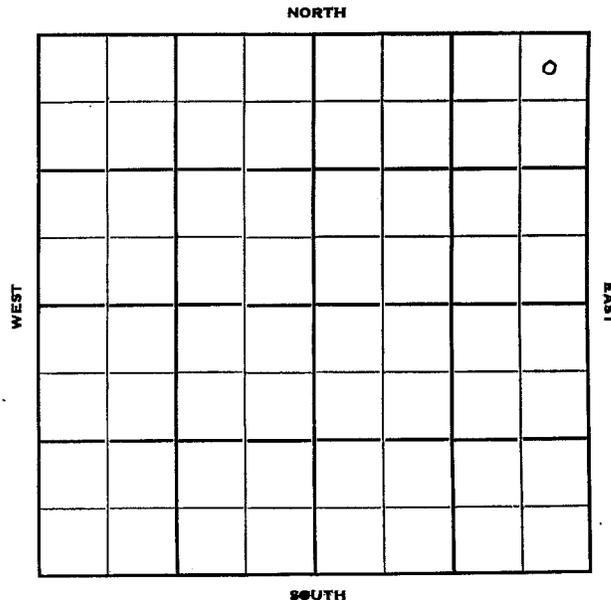

1951

Elev. 1298' REPORT

7/25

Location

9/26

Spud 7-26-51  
 Oil Well TD 3409  
 8" @ 342'  
 Miss 2886 Kh. 3172 Misner 3318  
 Hunton 3322 Maq. Sh. 3334  
 Maq. dol. 3406-08  
 5" @ 3406 TD 3409  
 FU 3008' oil 17 hr. 1000A  
 Comp. 612 bopd

COMPLETED