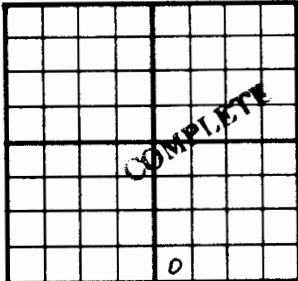


Drig. Data Smolin

Location _____

County	Saline		State	Kansas	
Sec.	36	(Blk. Twp.)	15	(Sur. Rge.)	4W Map No.
Operator	C R A				
Well No.	3	Farm	Carlson "B"		
Elev.	1319	Location	SW SE SE		
			330 Ft. From	S Line	SE
			330 Ft. From	W Line	Quarter
			1st. Report		
			Completion	DEC 1 0 1952	
			Remarks	Smolan Pool Shields - Contr.	
			Spudding Date	9-20-52	

Drilg. Data	Oil well	TD 3432
8" @ 368	Miss. 2913	Kh. 3197
Misener 3344	Hunton 3349	Maq. 3363
Dol. 3429	DST 3427-31	open 1 hr.
Rec. 180' gas	30' oil	30' ocm
5" @ 3429	TD 3432	B/ 58 gfph 5% wtr.
P/ 17 bo	3% wtr.	
Comp. 25	bepd	

J. G. McCLURE

KANSAS

Saline

Sec. 36 Twp. 15 R. 4W

Well No. #3 Carlson (B) Farm

C R A

Company

Shields - Contr.

Contractor

Smolin


Ft. from N. Line

330' Ft. from S. Line

Ft. from E. Line

330' Ft. from W. Line

SW SW SE

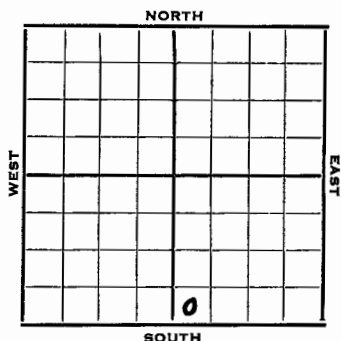


Saline KANSAS

Section 36 Township 15 Range 4W

Well No. #3 Carlson (B)

Company C R A

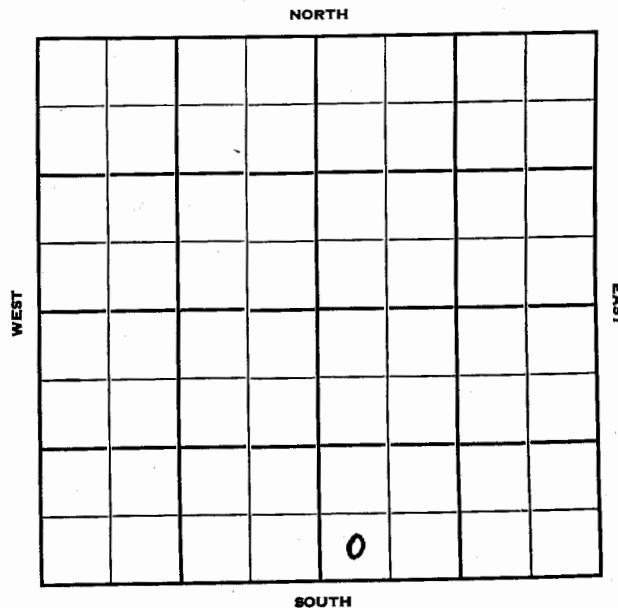

1952 REPORT

9/17 Location
9/24 8" @ 368
Drlg. 1520'
10/1 Miss 2917' KH 3201'
Drlg. 3330'
10/8 Misner 3344', Hunton 3349', Mq Sh
3263', Mq Dol 3 429
5" @ 3429
RTD 3431
Drlg. Deeper 3432 TD
Test 58 gfph 5% w, testing
10/15 "
10/22 P/17 BO & 3% wtr 24 hrs.
10/29 NR
11/5 "
11/12 "
11/20 "
11/27 "
12/4 "
12/10 Spud 9-20-52 Oil well TD 3432'
8" @ 368 Miss 2913' Kh. 3197'
Misener 3344' Hunton 3349' Maq. 3363
Dol. 3429'
DST 3427-31 open 1 hr. rec 180' gas,
30' oil, 30' OCM 5" @ 3429 TD 3432'
B/58 GFPH 5% wtr. P/17 BO 3% wtr.
Comp. 25 BOPD **COMPLETED**