


County Saline State Kansas
 Sec. 36 (Blk. Twp.) 15 (Sur. Rge.) 4W Map No.
 Operator C. R. A.
 Well No. 2 Farm Carlson (B)
 Elev. _____ Location SE SW SE

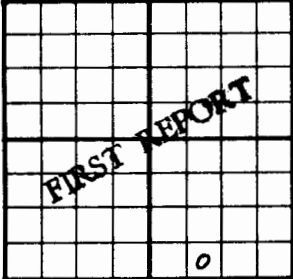

330 Ft. From S Line SE
990 Ft. From W Line Quarter

1st. Report JUL 11 1951

Completion _____

Remarks _____


Spudding Date _____

Drig. Data Smolan - pool

Location

J. E. TYRA

County Saline State Kansas
 Sec. 36 (Blk. Twp.) 15 (Sur. Rge.) 4W Map No.
 Operator C R A
 Well No. 2 Farm Carlson "B"
 Elev. 1313 Location SE SW SE

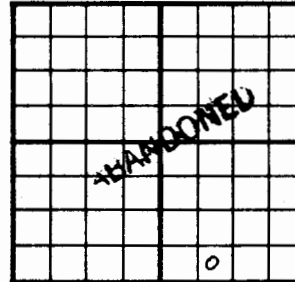

330 Ft. From S Line SE

990 Ft. From W Line Quarter

1st. Report _____

Completion AUG 1 1951

Remarks Smolan Pool

Spudding Date 7-15-51

Drig. Data D & A TD 3439

13" @ 75 8" @ 340 Miss. 2903

Kh. 3202 Hunton 3354 Maq. sh. 3366

Maq. dol. 3434 DST 3435-39 open 20 min.

Rec. 250' sw D & A

J. E. TYRA

Saline

KANSAS

Sec. 36 Twp. 15 R. 4 W ✓Well No. # 2 Carlson (B) Farm

C. R. A. Company

Smolan Pool

Contractor

Ft. from N. Line

330


Ft. from S. Line

Ft. from E. Line

990

Ft. from W. Line

SE SW SE

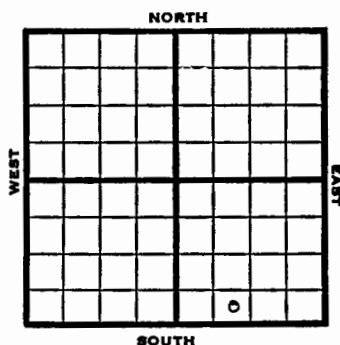

1951 Elev. 1313' REPORT

7/11 Location

8/1 Spud 7-15-51
D & A TD 3439' 13" @ 75
8" @ 340 Miss 2903' Kh. 3202'
Hunton 3354' Maq. sh. 3366'
Maq. dol. 3434'
DST 3435-39 open 20 min. rec 250' SW
D & A

ABANDONED

Saline

KANSAS

Section 36 Township 15 Range 4 WWell No. # 2 Carlson (B)Company C. R. A.