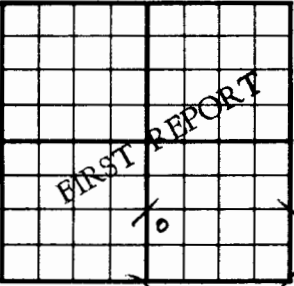
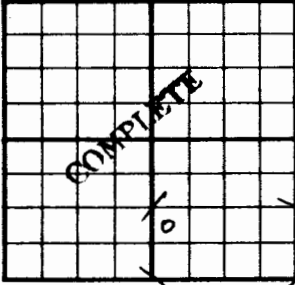


County	Saline		State	Kansas	
Sec.	36	(Blk. Twp.)	15	(Sur. Rge.)	4W
Operator	C R A				
Well No.	1	Farm	Carlson "B"		
Elev.	Location NW SW SE				
					
990 Ft. From S Line SE					
330 Ft. From W Line Quarter					
1st. Report JUN 6 1951					
Completion					
Remarks					
Honaker Drlg. - Contr.					
Spudding Date 6-3-51					

Drlg. Data

13 3/8" @ 80 drlg. 90

J. E. TYRA

County	Saline		State	Kansas	
Sec.	36	(Blk. Twp.)	15	(Sur. Rge.)	4W
Operator	C R A				
Well No.	1	Farm	Carlson "B"		
Elev.	Location NW SW SE				
					
990 Ft. From S Line SE					
330 Ft. From W Line Quarter					
1st. Report					
Completion JUL 3 1951					
Remarks					
Honaker Drlg. - Contr.					
Spudding Date 6-3-51					

Drlg. Data Oil well TD 3423

13 3/8" @ 80 Miss. 2909 Kh. 3193

Maq. sh. 3349 Dol. 3421 5" @ 3422

TD 3423 FU 500' oil Comp. 162 bopd

J. E. TYRA

Saline **KANSAS**

Sec. 36 Twp. 15 R. 4W

Well No. #1 Carlson "B" Farm

C R A Company

Honaker Drlg. -Contr. Contractor


Ft. from N. Line

990' Ft. from S. Line

Ft. from E. Line

330' Ft. from W. Line

NW SW SE

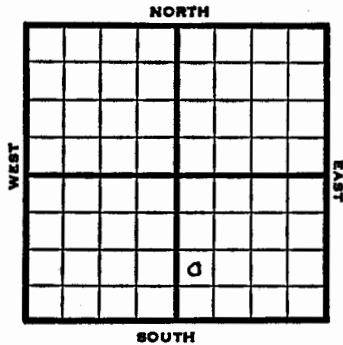


Saline **KANSAS**

Section 36 Township 15 Range 4W

Well No. #1 Carlson "B"

Company C R A

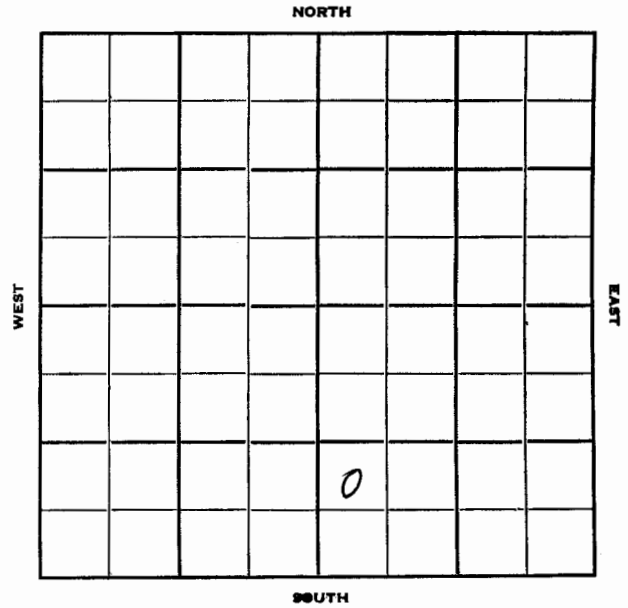

1951 Elev. 1314' REPORT

6/6 Spud 6-3-51
13-3/8" @ 80'
Drlg. 90'

7/3 Spud 6-3-51 Oil well TD 3423'
13-3/8" @ 80 Miss 2909' Kh. 3193'
Maq. sh. 3349' Dol. 3421'
5" @ 3422' TD 3423' FU 500' oil
Comp. 162 BOPD

COMPLETED