

FORM 252-B Saline KANSAS ✓
 Sec. 36 Twp. 15 R. 4W
 Well No. #7 Burk Farm
 Derby Oil Company

Shields Contractor
 Smolan Pool


Ft. from N. Line

990 Ft. from S. Line


330 Ft. from E. Line

Ft. from W. Line

SW $\frac{1}{4}$ NE SE SW

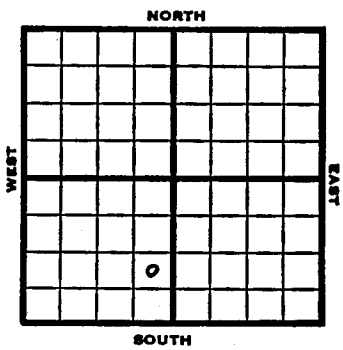

FORM 51 25M 3-49 PETROL Saline KANSAS
 Section 36 Township 15 Range 4W
 Well No. #7 Burk
 Company Derby Oil

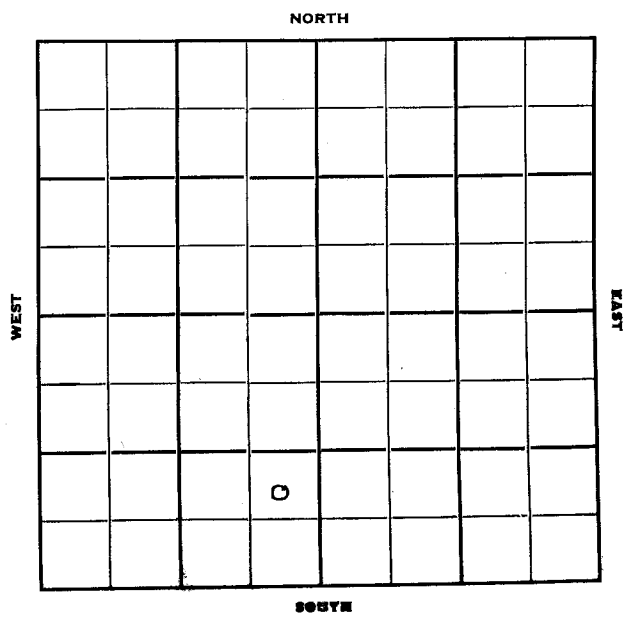

1952 Elev. 1317' REPORT

11/12 Location
 11/20 MIR
 11/27 Drlg. 2005'
 12/4 \emptyset 3270
 12/11 Miss 2914 KH 3199 Htn 3344 MQ Sho
 3353 MQ Dol 3425 RTD 3427 5" \bullet 3426
 CO 3427 1 GOPH DD 3428 500a DD 3430
 S/15 GOPH 500A S/8 $\frac{1}{2}$ BOPH 10 Hrs.

12/18 NR
 12/25 NR

1953
 12/7 Spud 11-20-52 Oil well TD 3430'
 8" \bullet 339 Miss 2914' Kh. 3199'
 Hunton 3344' Maq. sh. 3353' Maq.
 dol. 3425' TD 3427' 1 GOPH
 DD 3428' 500 A DD 3430 B/15 GOPH
 500 A S/9 $\frac{1}{2}$ BOPH 10 hr. P/69 BO
 7 hr. 1% wtr.
 Comp. 231 BOPD

COMPLETED