

Sec. 36 Twp. 15 R. 4 W

Well No. # 6 Burk Farm

Derby Oil Company

Contractor

Smolan Pool


Ft. from N. Line

330 Ft. from S. Line

330 Ft. from E. Line

Ft. from W. Line


SE SE SW

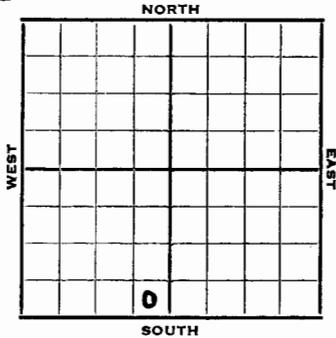

Section 36 Township 15 Range 4W

Well No. #6 Burk

Company Derby Oil

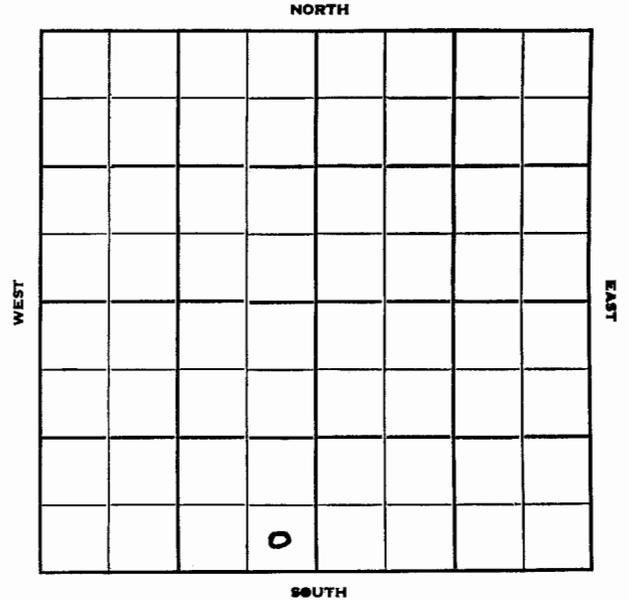

1952 Elev. 1319' REPORT

7/9 Location
 7/17 "
 7/23 "
 7/30 "
 8/6 "
 8/13 "
 8/20 8" @ 340
 8/27 Drlg. 2240'
 9/3 Miss. 2902 KH 3200
 Htn 3350 Mq sha 3360
 Mq Dol 3425-29 RTD
 5" @ 3427
 9/10 DP
 9/17 CO 3429' Fill up 1300' oil 13 hrs.
 S/3½ BOPH 1000 A S/20 BOPH
 Fill up 1800' oil 7 hrs. POP
 9/24 P/65 B0 6 hrs.
 10/1 Spud 8-18-52
 Oil well TD 3429' 8" @ 340
 Miss 2902' Kh. 3200' Hunton 3350'
 Maq. sh. 3360' Maq. dol. 3425'
 TD 3429' 5" @ 3427 CO to 3429'
 FU 1300' oil, 13 hr. S/3½ BOPH 3 hr.
 1000 A S/20 BOPH FU 1800' oil 7 hr.
 Comp. 228 BOPD

COMPLETED