


County Saline State Kansas
 Sec. 36 (Blk. 15 (Sur. 4W Map No.
 Operator Derby Oil
 Well No. 5 Farm Burk
 Elev. _____ Location C N L N $\frac{1}{2}$ SW

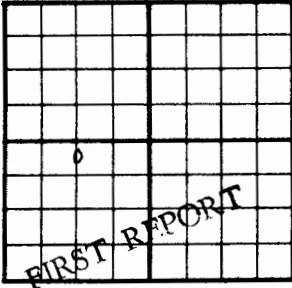


330 Ft. From N Line SW
1320 Ft. From W Line Quarter
 Ist. Report JUL 9 1952
 Completion _____
 Remarks _____
 Spudding Date _____

Drig. Data

Smolan PoolLocation

J. G. McGEHEE

County Saline State Kansas
 Sec. 36 (Blk. 15 (Sur. 4W Map No.
 Operator Derby Oil
 Well No. 5 Farm Burk
 Elev. 1321 Location C N L N $\frac{1}{2}$ SW

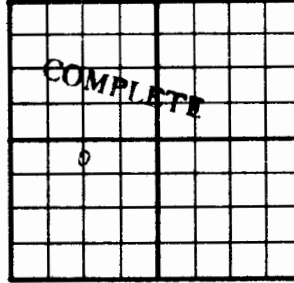

330 Ft. From N Line SW
1320 Ft. From W Line Quarter
 Ist. Report _____
 Completion SEP 10 1952
 Remarks Smolan Pool
 Spudding Date 8-5-52

Drig. Data Oil well TD 34388" @ 340 Miss. 2910 Kh. 3200Hunton 3356 Maq. sh. 3370 Maq. dol. 3436TD 3438 5" @ 3437 CO to 3438S/ 10 bo P/ 10 boph Comp. 225 bopd

J. G. McGEHEE

Saline KANSAS

Sec. 36 Twp. 15 R. 4 W

Well No. # 5 Burk Farm

Derby Oil Company

Contractor

Smolan Pool


330 Ft. from N. Line

Ft. from S. Line

Ft. from E. Line

1320 Ft. from W. Line

C N L N/2 SW

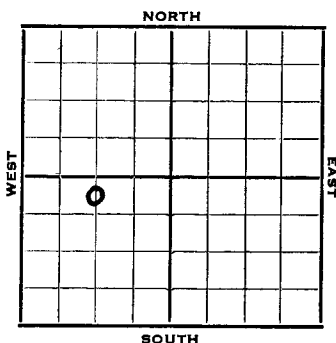

1952 Elev. 1321 REPORT

7/9 Location

7/17 "

7/23 "

7/30 "

8/6 Drlg. 250'

8/13 8" @ 340'

Drlg. 2787'

8/20 Miss 2910' KH 3200' Htn 3356'

Mq shale 3370' Mq Dol 3436'

RTD 3438' 5" @ 3437'

8/27 CO 3438 S/10 BO

9/3 P./10 Boph

9/10 Spd 8-5-52 Oil Well TD 3438

8" @ 340 Miss 2910 Kh 3200

Hunton 3356 Maq. sh 3370

Maq. dol. 3436 TD 3438

5" @ 3437 CO to 3438

S/10 bo P/10 boph Comp. 225 bopd

COMPLETED

Saline KANSAS

Section 36 Township 15 Range 4W

Well No. #5 Burk

Company Derby Oil

