

Saline

KANSAS

Sec. 36 Twp. 15 R. 4 W

Well No. # 4 Burk Farm _____

Derby Oil Company _____

Carey Drlg. Contractor _____

Smolan Pool


330 Ft. from N. Line

_____ Ft. from S. Line

_____ Ft. from E. Line

330 Ft. from W. Line

NW NW SW

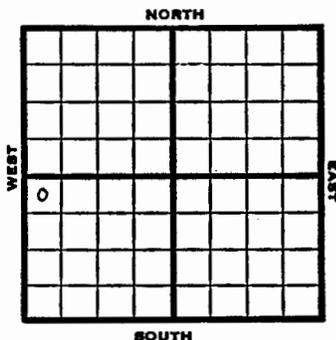


Saline

KANSAS

Section 36 Township 15 Range 4 W

Well No. # 4 Burk

Company Derby Oil

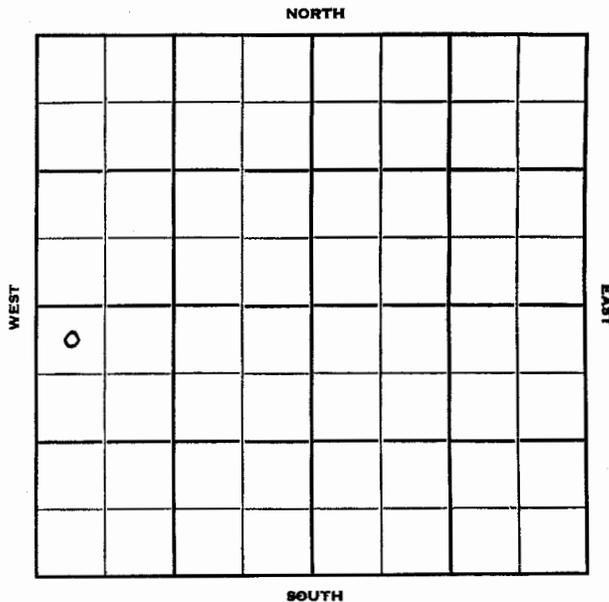

1951	Elev. 1314' REPORT
9/26	Spud 9-21-51 8" @ 324 Drlg. 1780'
11/14	Spud 9-21-51 Oil well TD 3426' 8" @ 324 Miss 2904' Maq. 3424' TD 3426' 4 1/2" @ 3425' FU 1600' oil 2 hr. S/18 BO 2 hr. Kh. 3200' Hunton 3332' Maq. sh. 3342' 300 A 500 A Comp. 1009 BOPD COMPLETED